
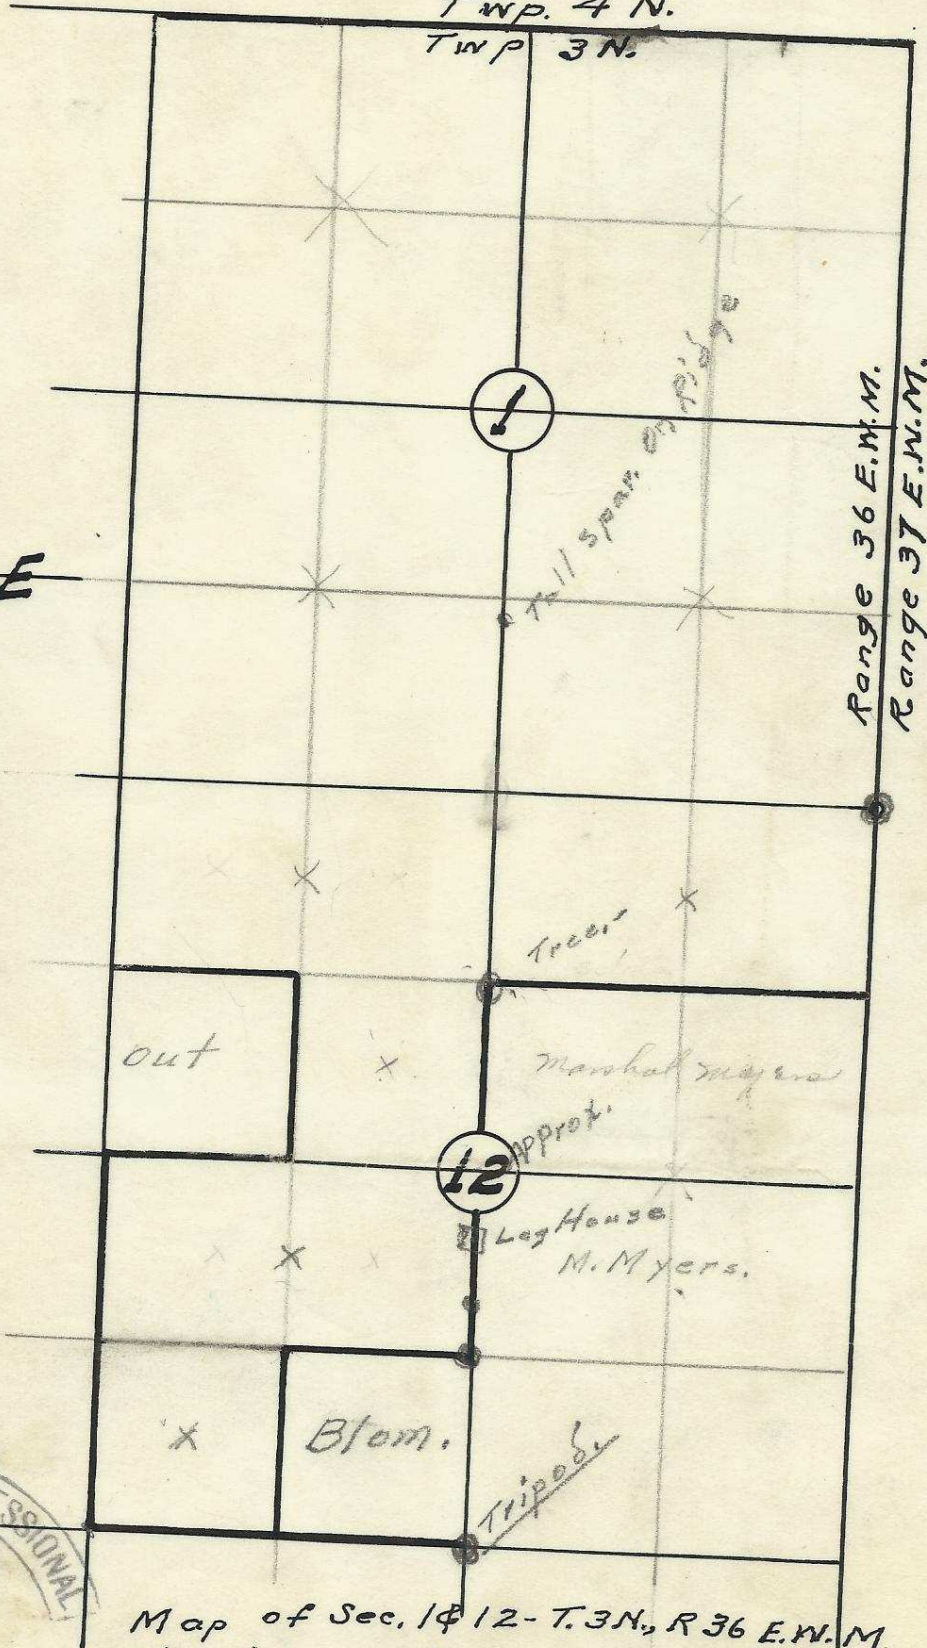


Twp. 4 N.
Twp 3 N.

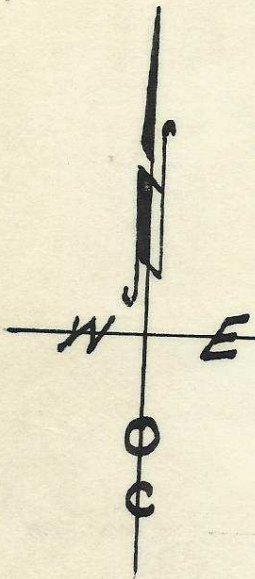

Map of Sec. 1 & 12 - T. 3 N., R. 36 E. W. M.
showing portions owned by
O. Jay Brogotti.
surveyed, staked, & platted,
By W.E.O. Criger.

Scale: 4" = 1 mile.

~~542 Ax~~

May-1951

09-159-Ax

3

