


30 29  
31 32

29 28  
32 33

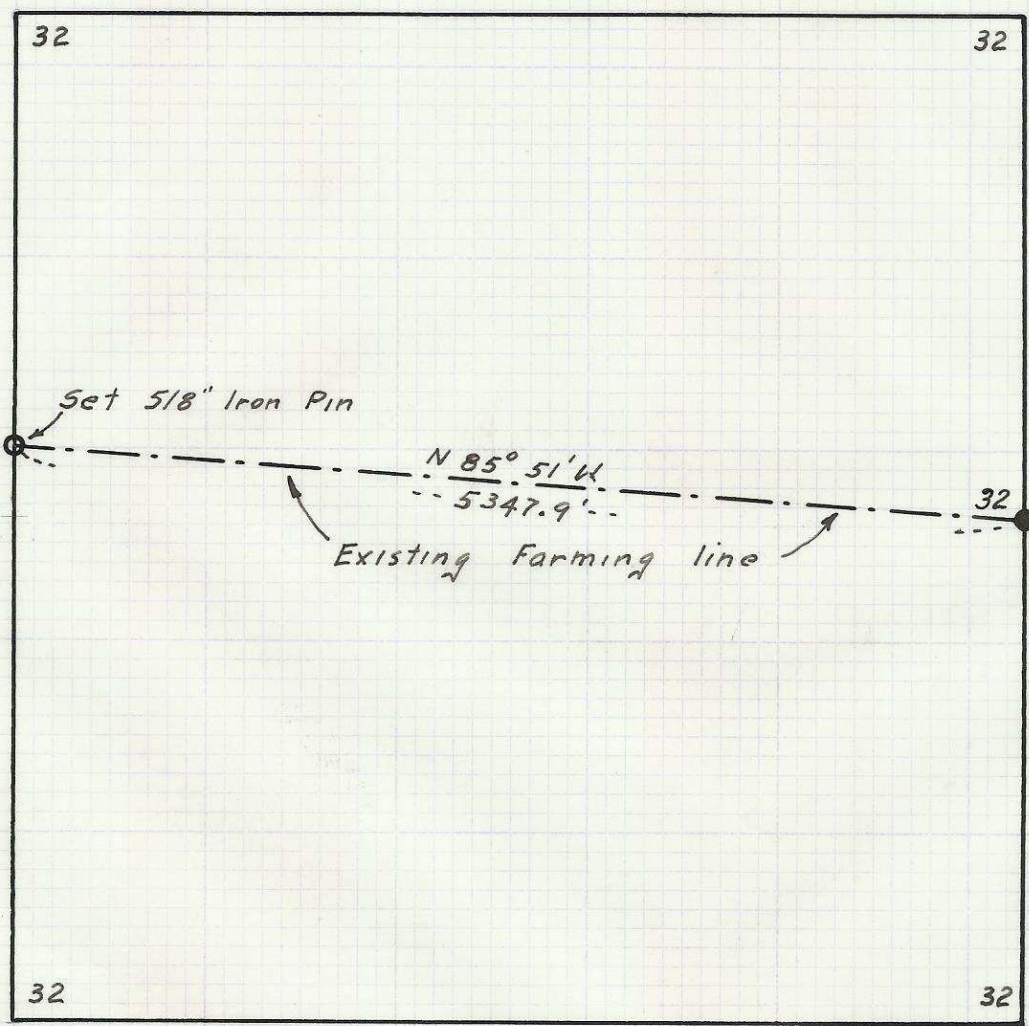

31 32  
6 5

32 33  
5 4

REGISTERED  
**OREGON**  
 LAND SURVEYOR  
*Wayne O. Harris*  
 MAY 6, 1955  
**WAYNE O. HARRIS**  
**346**

A-24

HAYES AND HARRIS

SURVEY FOR  
 MRS. IONE OSGOOD  
 SEC. 32 T. 6 N., R. 32 E.W.M.

SCALE	DATE	DRN. BY.	DRNG. No.
1"=1000'	5-12-65	WOH	65-216