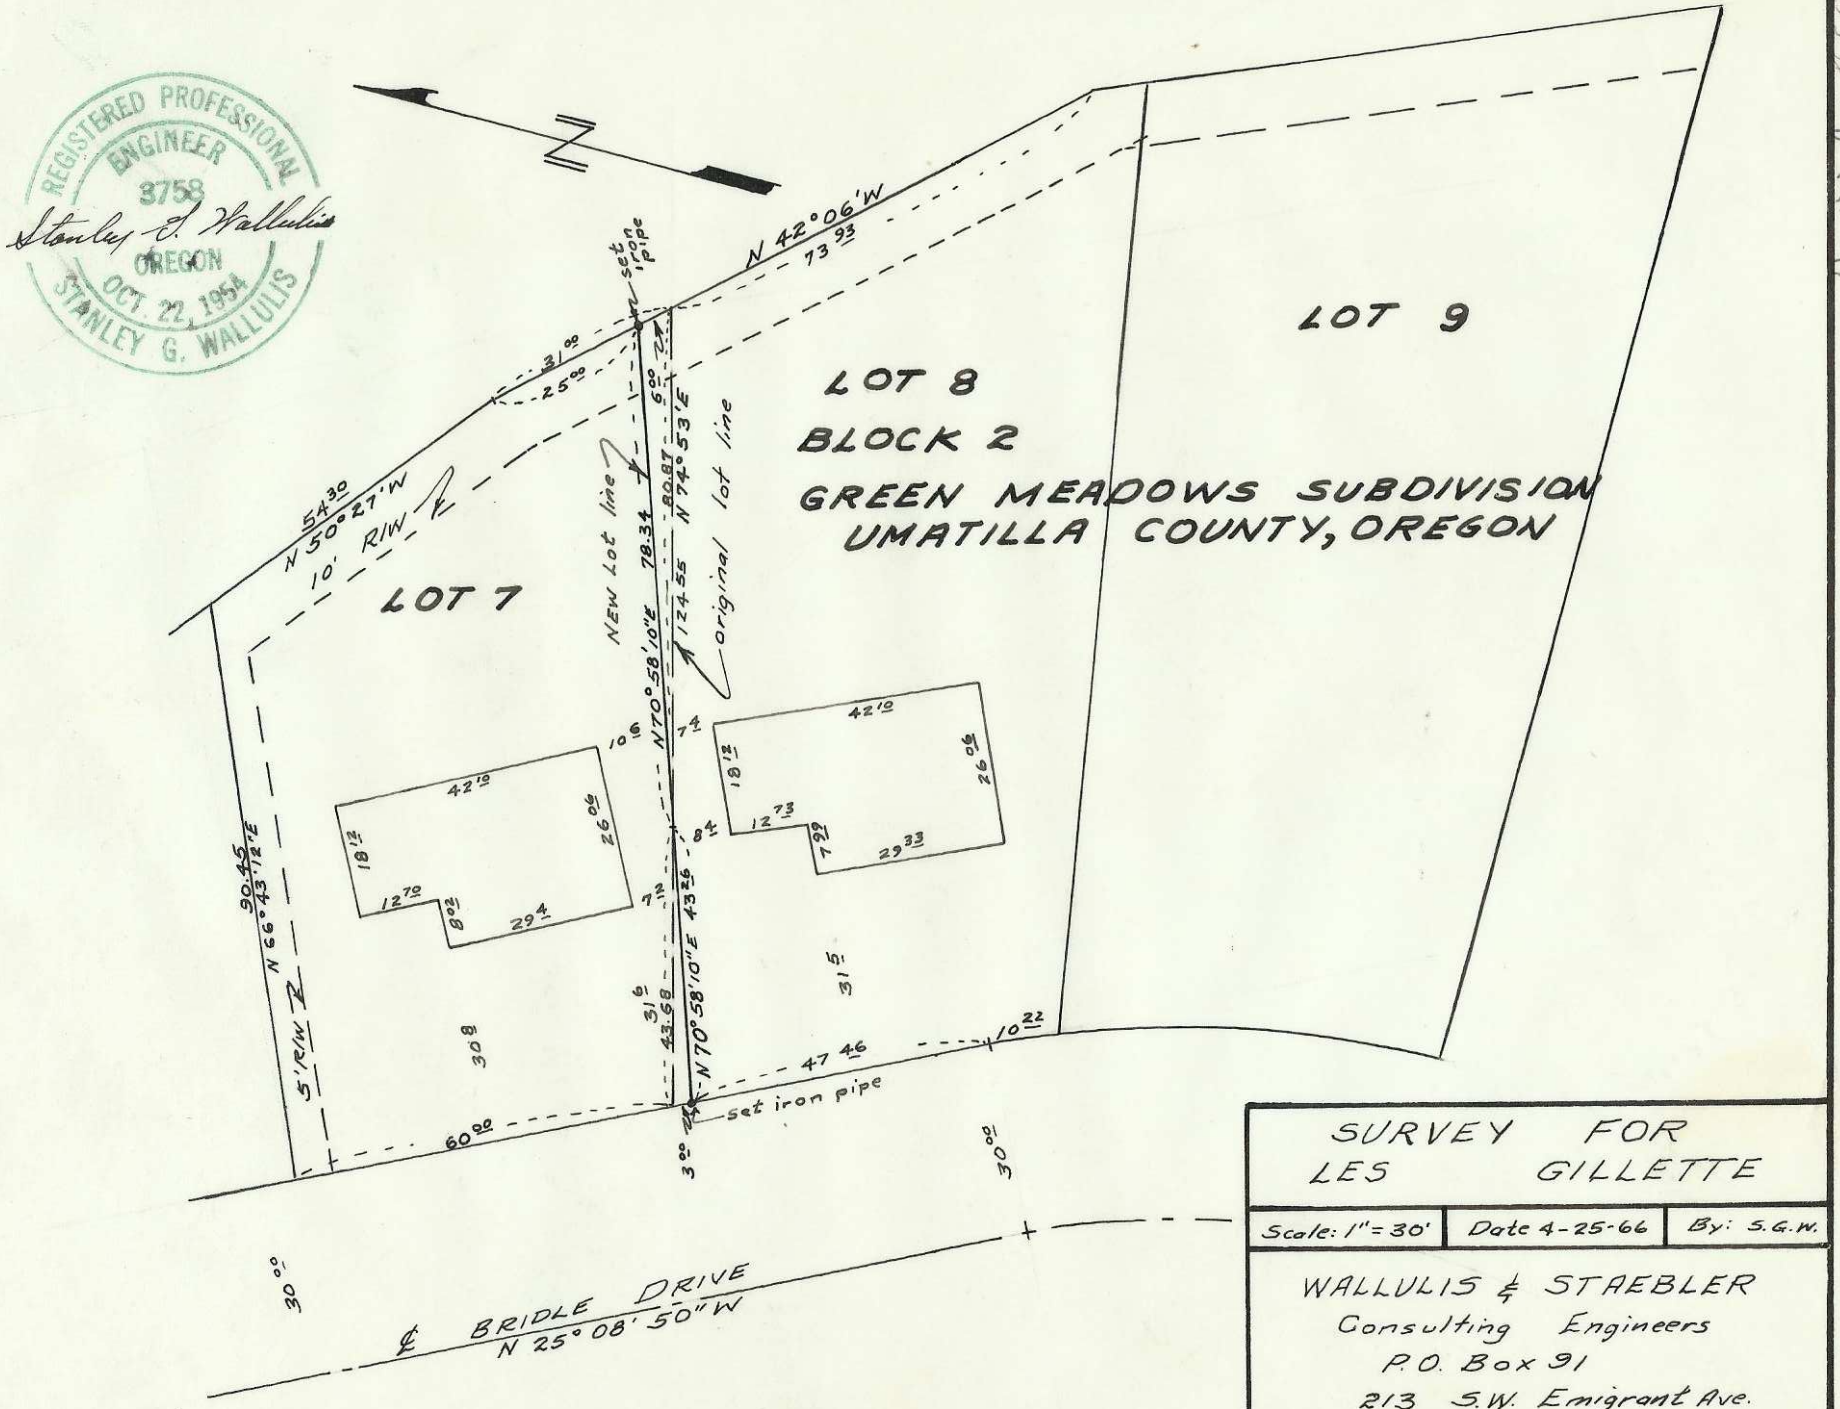

SURVEY FOR
LES GILLETTE

Scale: 1" = 30'	Date 4-25-66	By: S.G.W.

WALLULIS & STAEBLER
Consulting Engineers
P.O. Box 91
213 S.W. Emigrant Ave.
Pendleton Oregon

A-50-A x A-50

A-50