


A-51-A-47-51

WOOD ST.

O'BRIEN

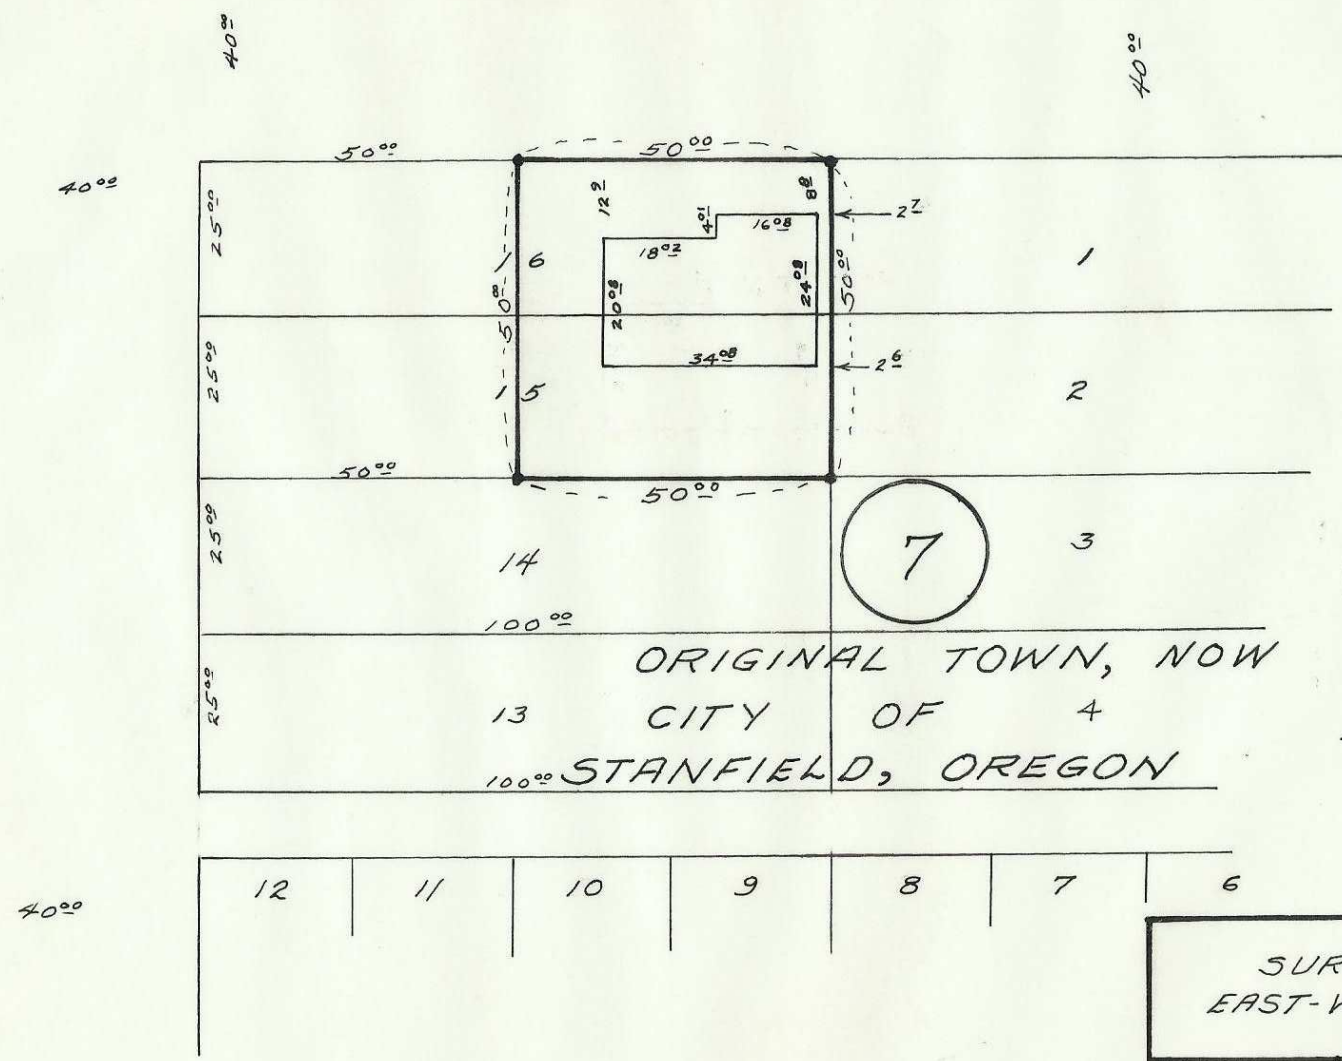

SURVEY FOR
EAST-WEST REALTY

Scale: 1"=30' Date: 4-25-66 By: S.G.W.

WALLULIS & STAEBLER
Consulting Engineers
P.O. Box 91
Pendleton Oregon

4-29-3ACA

A-51