


REGISTERED  
OREGON  
LAND SURVEYOR

*Ralph P. Thompson*

MAY 13, 1960  
RALPH P. THOMPSON  
506

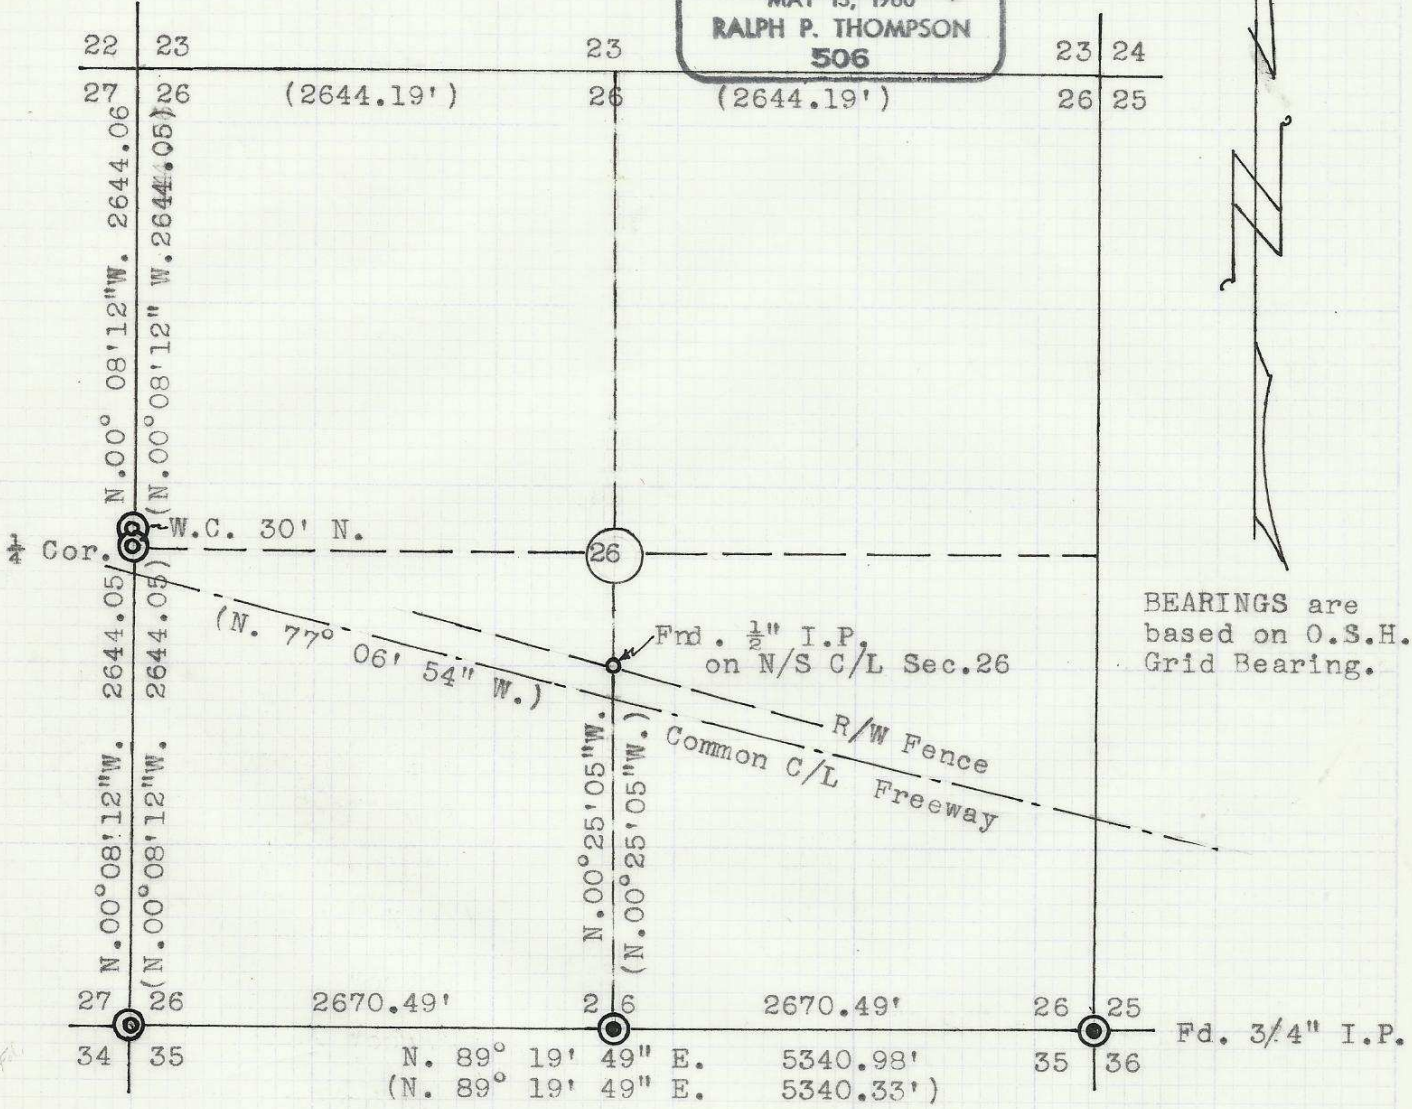

BEARINGS are based on O.S.H. Grid Bearing.

LEGEND

- Fnd. B.C. Monument
- Set B.C. Monument
- ( ) Bearings and Distances Per Staebler Survey, 1971

H-38

SURVEY FOR JOHN KING TR INE Sec. 26, T.4N. R.27 EWM	
Scale: 1"=1000'	Date: 8-24-71
<b>RALPH THOMPSON</b> REGISTERED LAND SURVEYOR P. O. BOX 1082 PENDLETON, OR 97801	

H-38-Ax