



Sec. 24, T.6N., R.35E.

H-104-Ax

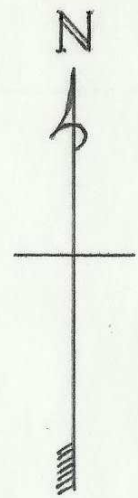

Scale: 1"=100'

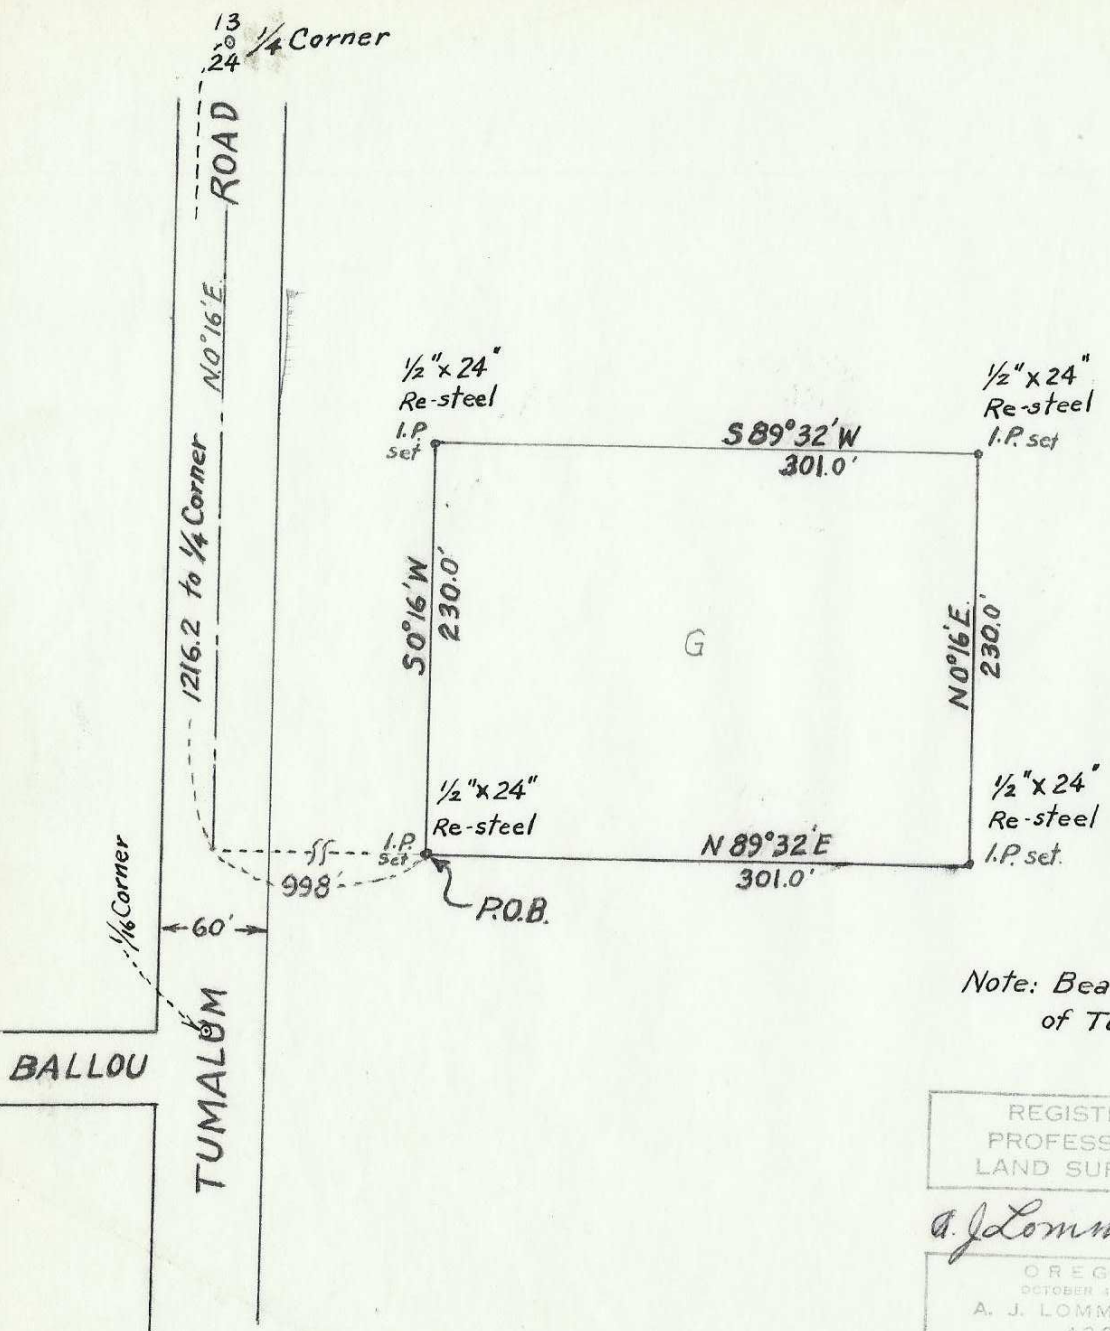

Note: Bearings shown are based on centerline of Tumalum Road which is N 0° 16' E

REGISTERED PROFESSIONAL LAND SURVEYOR

A. J. Lommasson

OREGON
OCTOBER 3, 1957
A. J. LOMMASSON
422

ALLEN J. LOMMASSON
Registered Surveyor
142 THORNE
WALLA WALLA, WASHINGTON

Survey for
JOHN R. STARLIN

4/8/72

H-104