
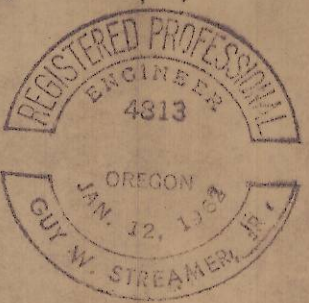


H-131-H

ORIGINAL

RIVERSIDE

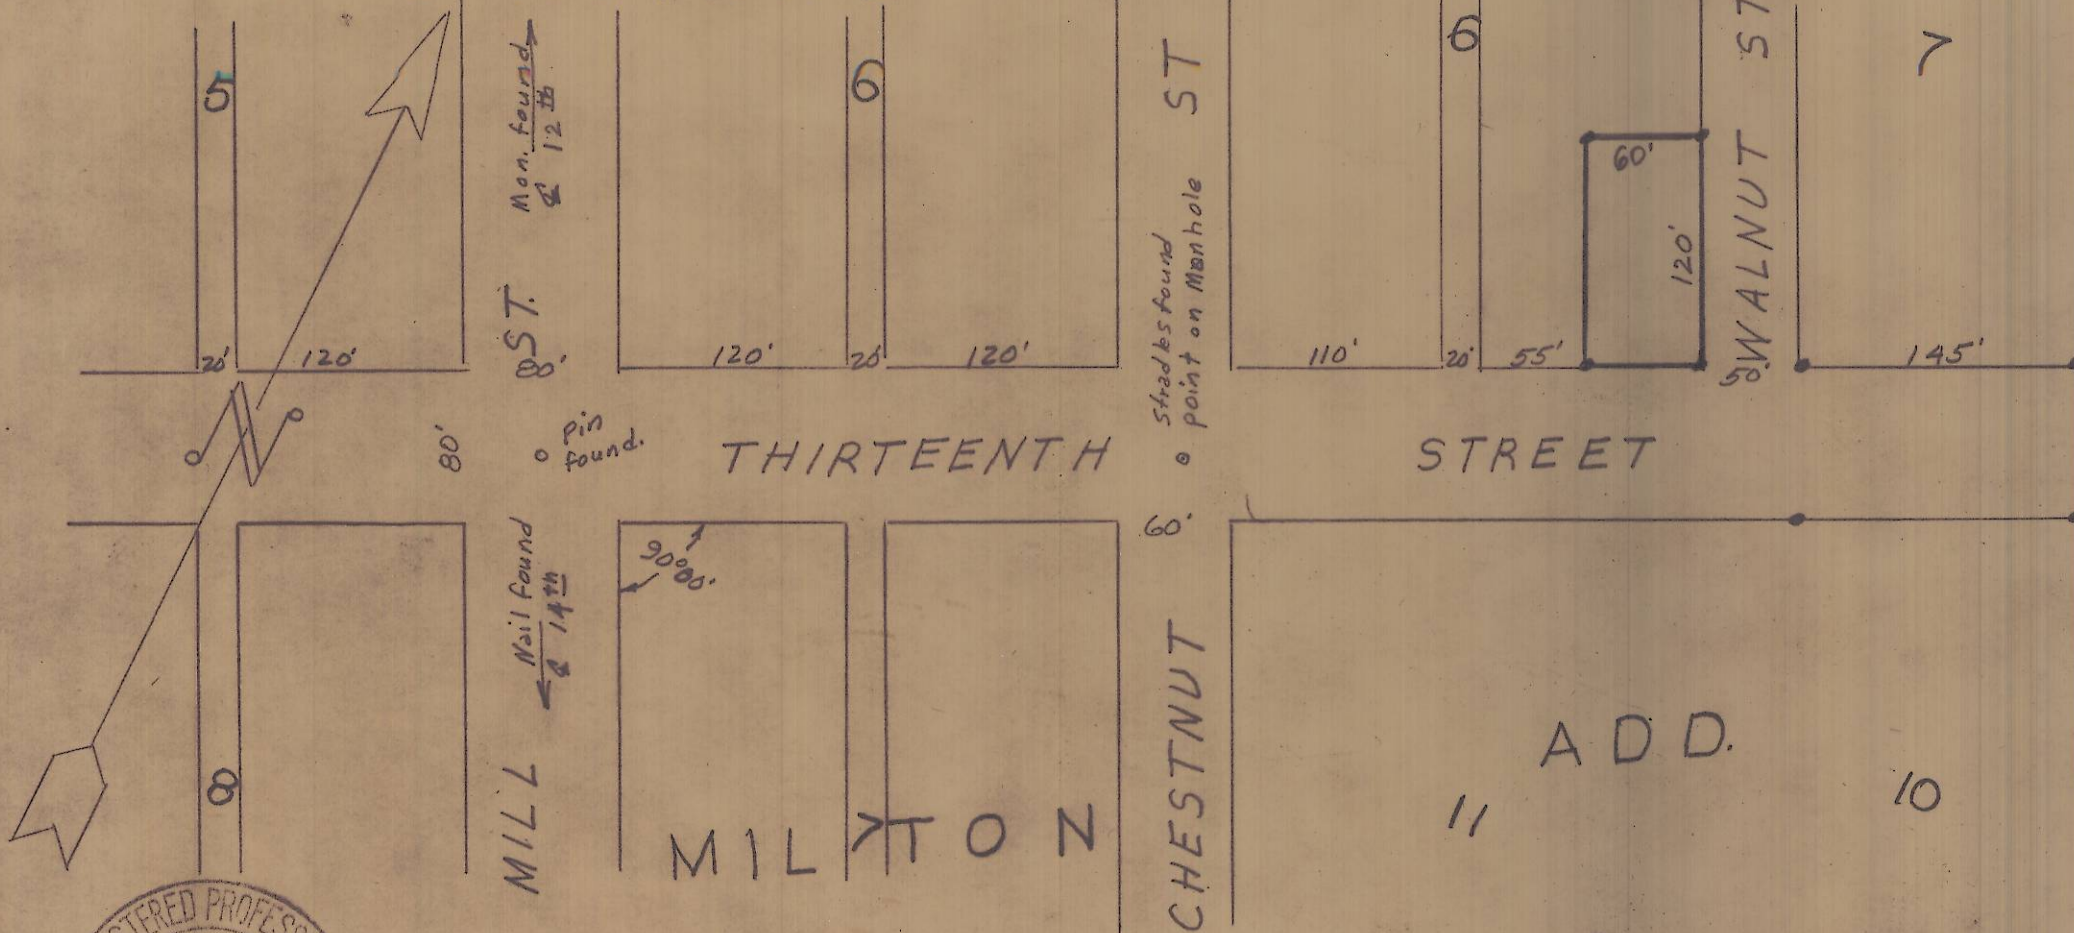

SURVEY FOR
 MRS. FRED MILLER AND
 CITY OF MILTON FREEWATER

scale 1" = 100' Aug. 14, 1971
 Guy W. Streamer
 Professional Engineer

SN-35-120B

Survey 577

H-131