

H-132-A

1/4 Cor
Mon. found

PEABODY STREET

38'

330.0

60'

60'

630.0


89°27 1/2'

60'

N. ELIZABETH STREET

Iron pin found

Monuments found in
Fifth Street and
Broadway

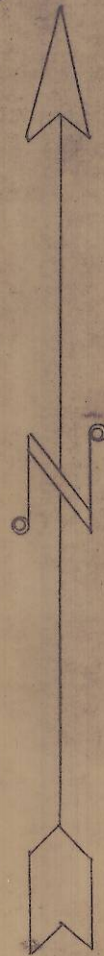

SURVEY FOR
MIGRANT LABOR CAMP
MILTON FREE WATER, ORE.
Scale 1"=100' Nov. 1, 1967

Guy W. Streamer, Jr.
PROFESSIONAL ENGINEER

SN-35-01CB

SURVEY 377
H-132