


T-64-Ax



Legend ✓
 ○ 1/2" x 24" Iron pins set
 □ Markers found as noted
 (N 0°-12' E) Bearings as given in
 Fraley's Survey of Sec. 12 on file
 in Co. Surveyors Office.
 Other bearings as given for description
 of property.

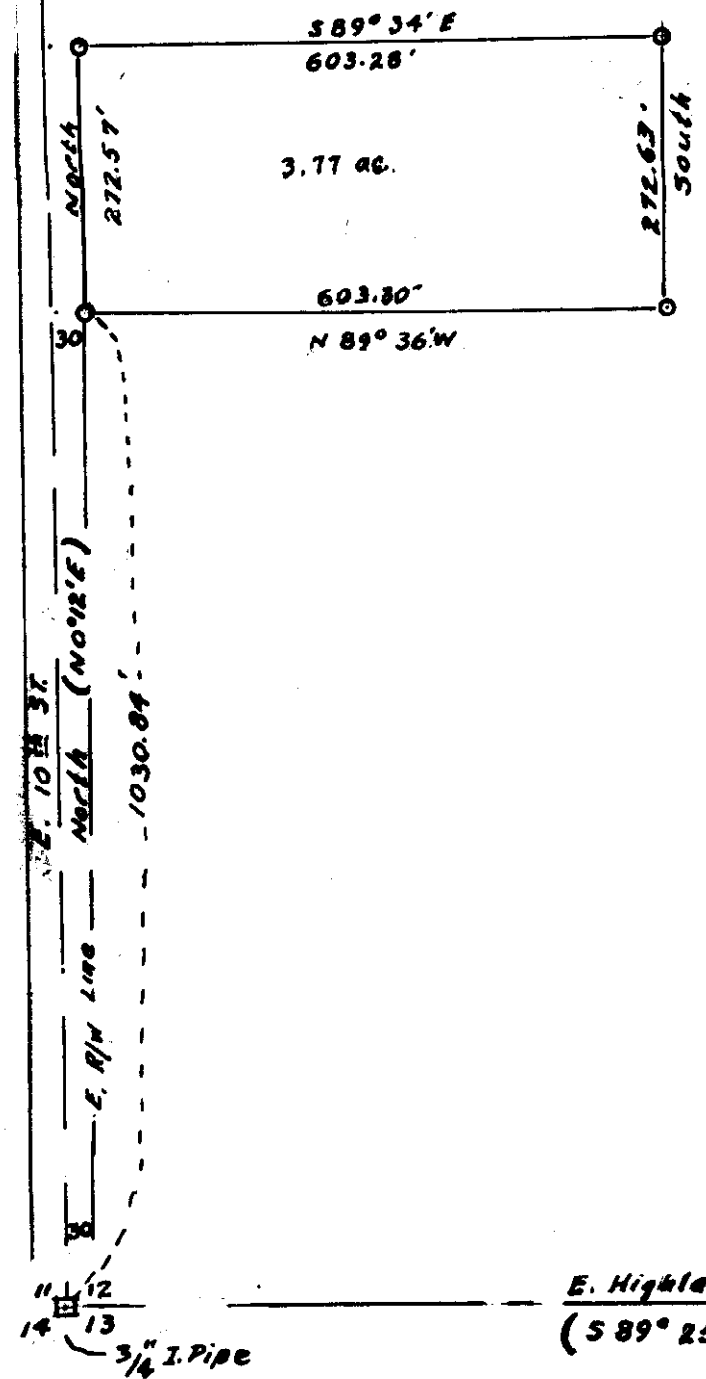

T-64

PLAT OF SURVEY OF TRACT
 IN S.W. 1/4 SEC. 12, T4N., R28E W.M.
 UMATILLA CO. ORE.
 FOR LEON F. POWELL
 SCALE 1" = 200' 9/9/44

E. Highland Ave.
 (S 89° 25' E)
 30' (13)
 1/2" x 24" I.P.P.