


CRIST

4 ACRES

CO. RD. 604

CO. RD. #611

- POINTS FOUND AS NOTED
- POINT SET $\frac{1}{2}$ " x 24" IRON PINS

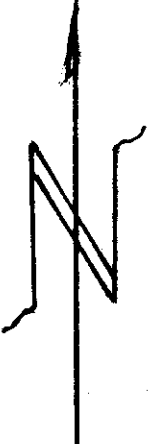

FOR JOHN PAULSON & EARL CROW

I-65

SURVEY OF FOUR ACRES
IN SW $\frac{1}{4}$, SEC. 1, T4N, R28E, WM,
UMATILLA COUNTY OREGON

SCALE 1" = 100' 5/15/74

I-65-A2