


SURVEY FOR
TERRY CHILDERS
 SECTION 32 T.6N., R.35E.W.M.
 Scale 1"=800' Apr. 25, 1973

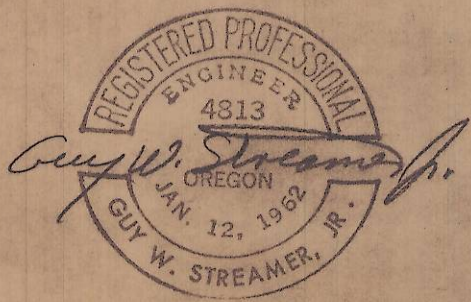

I-89-18

Survey 666