


514

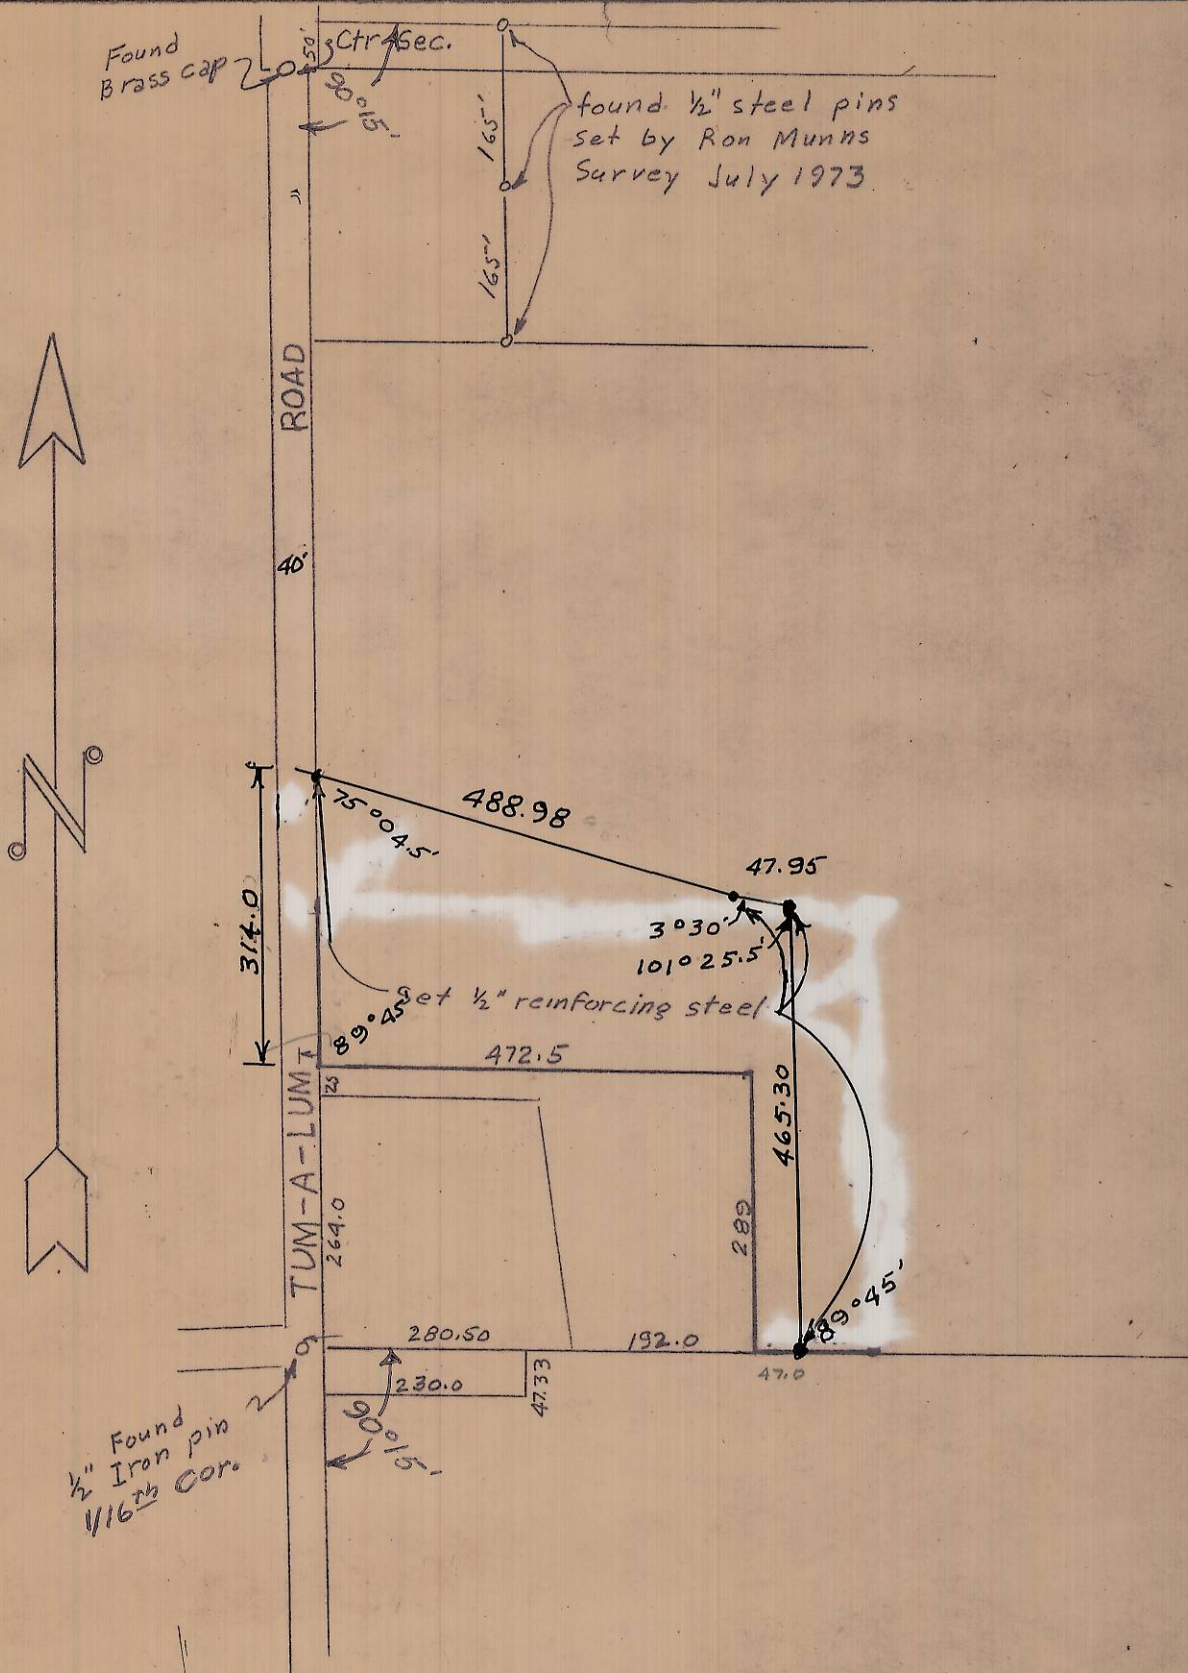

SURVEY FOR
SCHOOL DISTRICT #4
UMATILLA COUNTY, OREGON

Scale 1" = 200' Dec. 17, 1973

SE 1/4 Sec. 24 GN 35



I-92