


27 26  
34 35  
2" I. Pipe & Pin

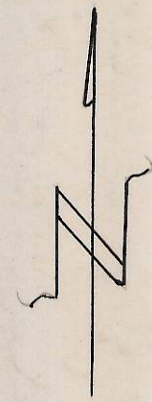

LEGEND:  
 □ POINTS FOUND AS NOTED  
 ○ POINTS SET 1/2" x 24" REBARS  
 BEARINGS BASED ON E. LINE OF SEC. 34  
 BEING N 0° 05' 45" W AS SHOWN IN  
 SURVEYS IN SECTIONS 34 & 35 ON  
 FILE IN COUNTY SURVEYORS OFFICE

6.05 ac. m/e

TROTTS ADDITION



J  
75-9

SURVEY PLAT OF TRACT  
 IN SW 1/4 / NE 1/4 SEC. 34 T5N, R28E, W.M.  
 UMATILLA COUNTY  
 FOR BERT ROZEMA  
 SCALE 1" = 100' 2/17/75

RR 1/2" I. Pin  
 33' 35' 60'  
 33' 35' 60'