



PLAT OF SURVEY
 OF
 LOTS 9 & 10, BLOCK 10, ORIGINAL TOWN OF FREEWATER, NOW
 CITY OF MILTON-FREEWATER; UMATILLA COUNTY, OREGON

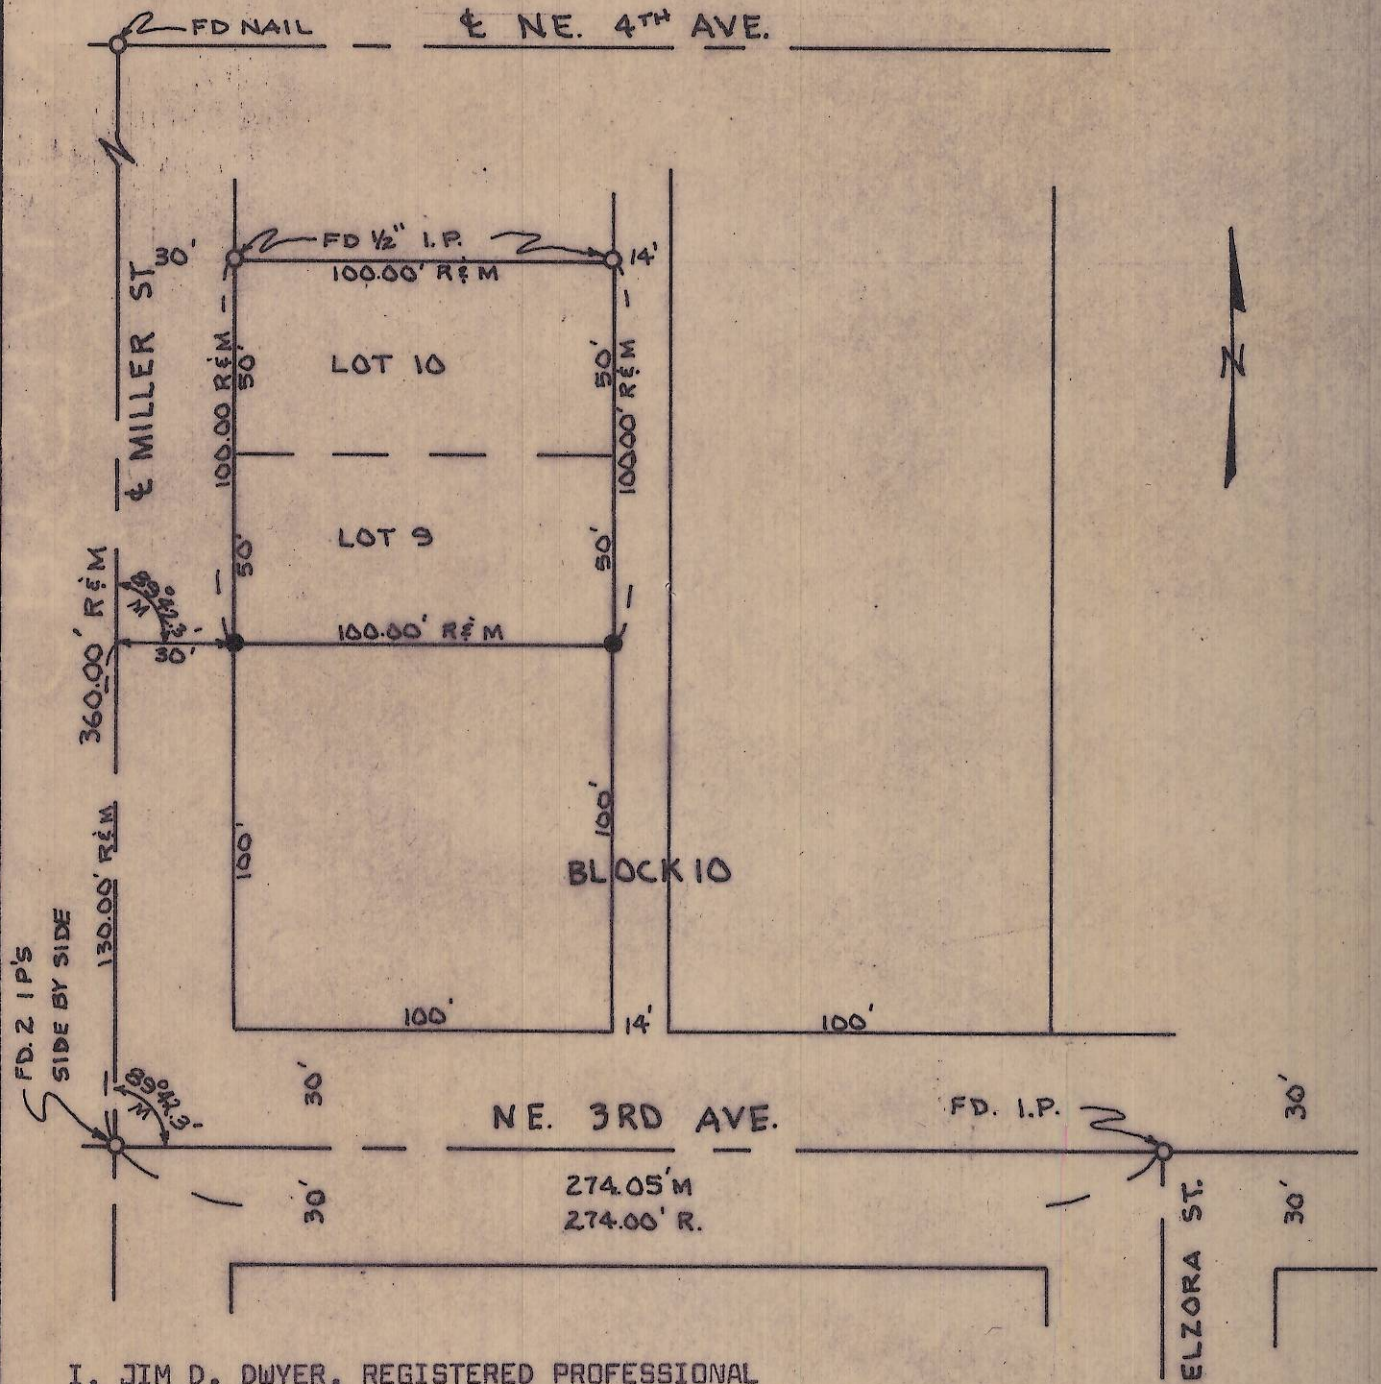

I, JIM D. DWYER, REGISTERED PROFESSIONAL ENGINEER, HEREBY CERTIFY THAT I HAVE SURVEYED THE PROPERTY DESCRIBED HEREON AND THE PLAT HEREDON DRAWN IS A CORRECT REPRESENTATION OF SAME.

- = SET 3/8" IRON PIN
- R = RECORD
- M = MEASURED

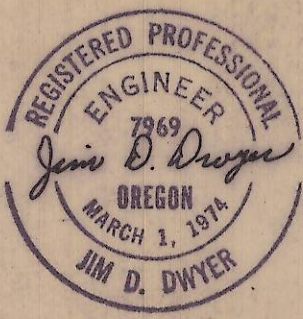

SURVEY FOR JOHN GERDES
 308 MILLER ST.
 MILTON FREEWATER, OREGON
 BY:
 JIM D. DWYER
 PROFESSIONAL ENGINEER
 10 N. MADISON ST., WALLA WALLA, WA.
 DATE: 6-10-75 SCALE: 1" = 50'