
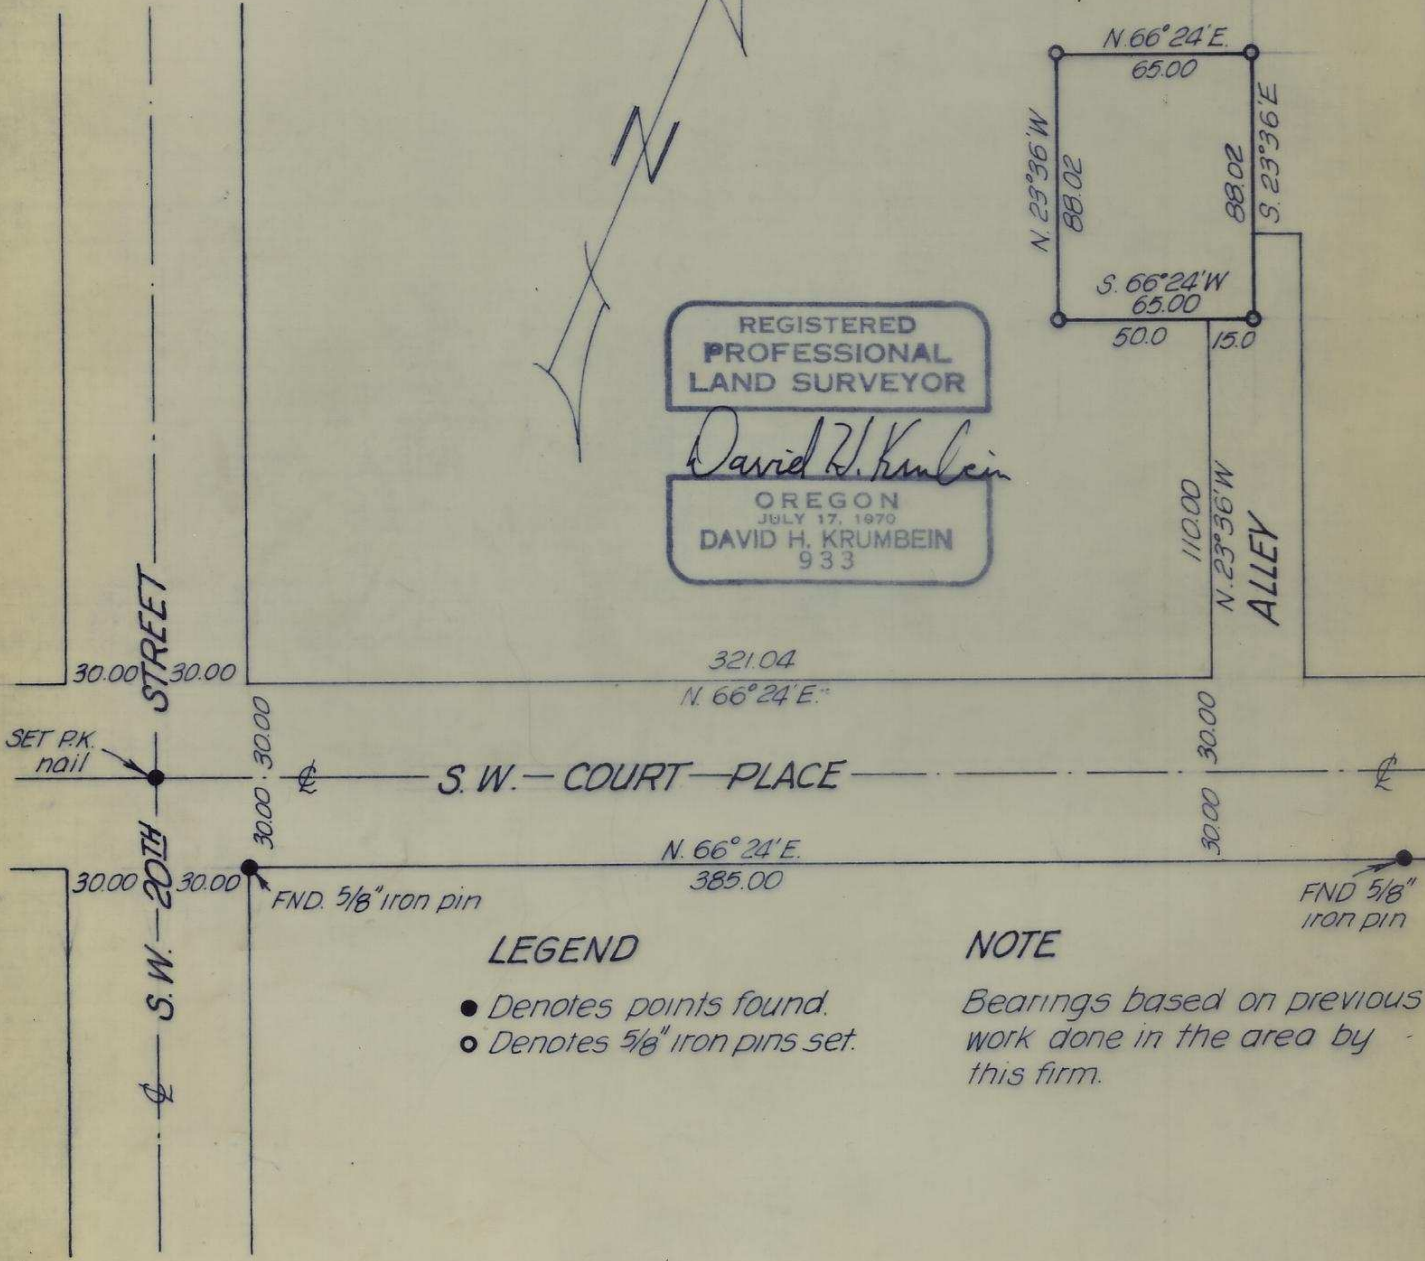


REGISTERED
PROFESSIONAL
LAND SURVEYOR

David H. Krumbein

OREGON
JULY 17, 1970
DAVID H. KRUMBEIN
933

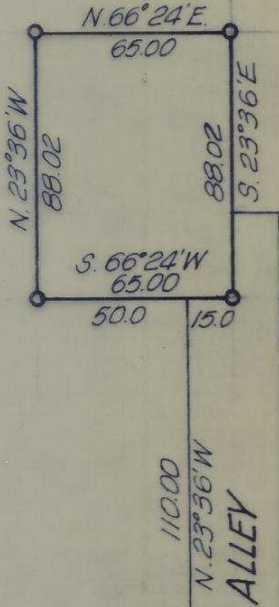

LEGEND

- Denotes points found.
- Denotes 5/8" iron pins set.

NOTE

Bearings based on previous work done in the area by this firm.

SURVEY FOR
HAROLD HENDRICS
SITUATED IN BLOCK 26, "HAZEN ADDITION",
PENDLETON, OREGON.

WAYNE HARRIS CO. INC.
ENGINEERS - SURVEYORS
PENDLETON, ORE.

SCALE	1"=60'	DRN. BY	C.T.P.	DRGN. NO.
DATE	4-2-75	CKD. BY	D.H.K.	75-403

J-68-A