

J-137-A

SEC. LINE MARKERS

C. of E.
Brass Disk

C. of E. K
Brass Disk

635.0'

OLD $\frac{1}{2}$ OF U.S. HI'WY 730 CONFORMING
TO PROPERTY DESCRIPTION
(Parallel to existing $\frac{1}{2}$)

South on West Line of Sec. 18
763.2'


North parallel to West Line of Sec. 18
866.8'

821.6 EAST

S.W. COR.
NW $\frac{1}{4}$ /SW $\frac{1}{4}$
SEC. 18

Fd. 1" I. PIPE (undisturbed)
Tie point for retracement
of survey

Reset Disturbed
1" Iron Pin 2' South
& 1' West to conform
to property description

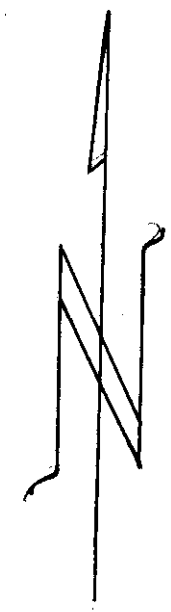

DIRECTIONS RELATIVE TO WEST LINE OF SEC. 18 BEING NORTH/SOUTH

RETRACEMENT OF PROPERTY SURVEY
IN NW $\frac{1}{4}$ OF S.W. $\frac{1}{4}$ SEC. 18, T5N, R28E, W.M.
FOR FORD SHOCKMAN
SCALE 1" = 200' 4/21/75

J-137