


Survey for Vernon Henderson in S.W. 1/4 Sec. 3,  
 T4N, R28E, W.M., Umatilla Co., Oregon, 12/17/75

Denny Edwards P.O. Box 805, Hermiston

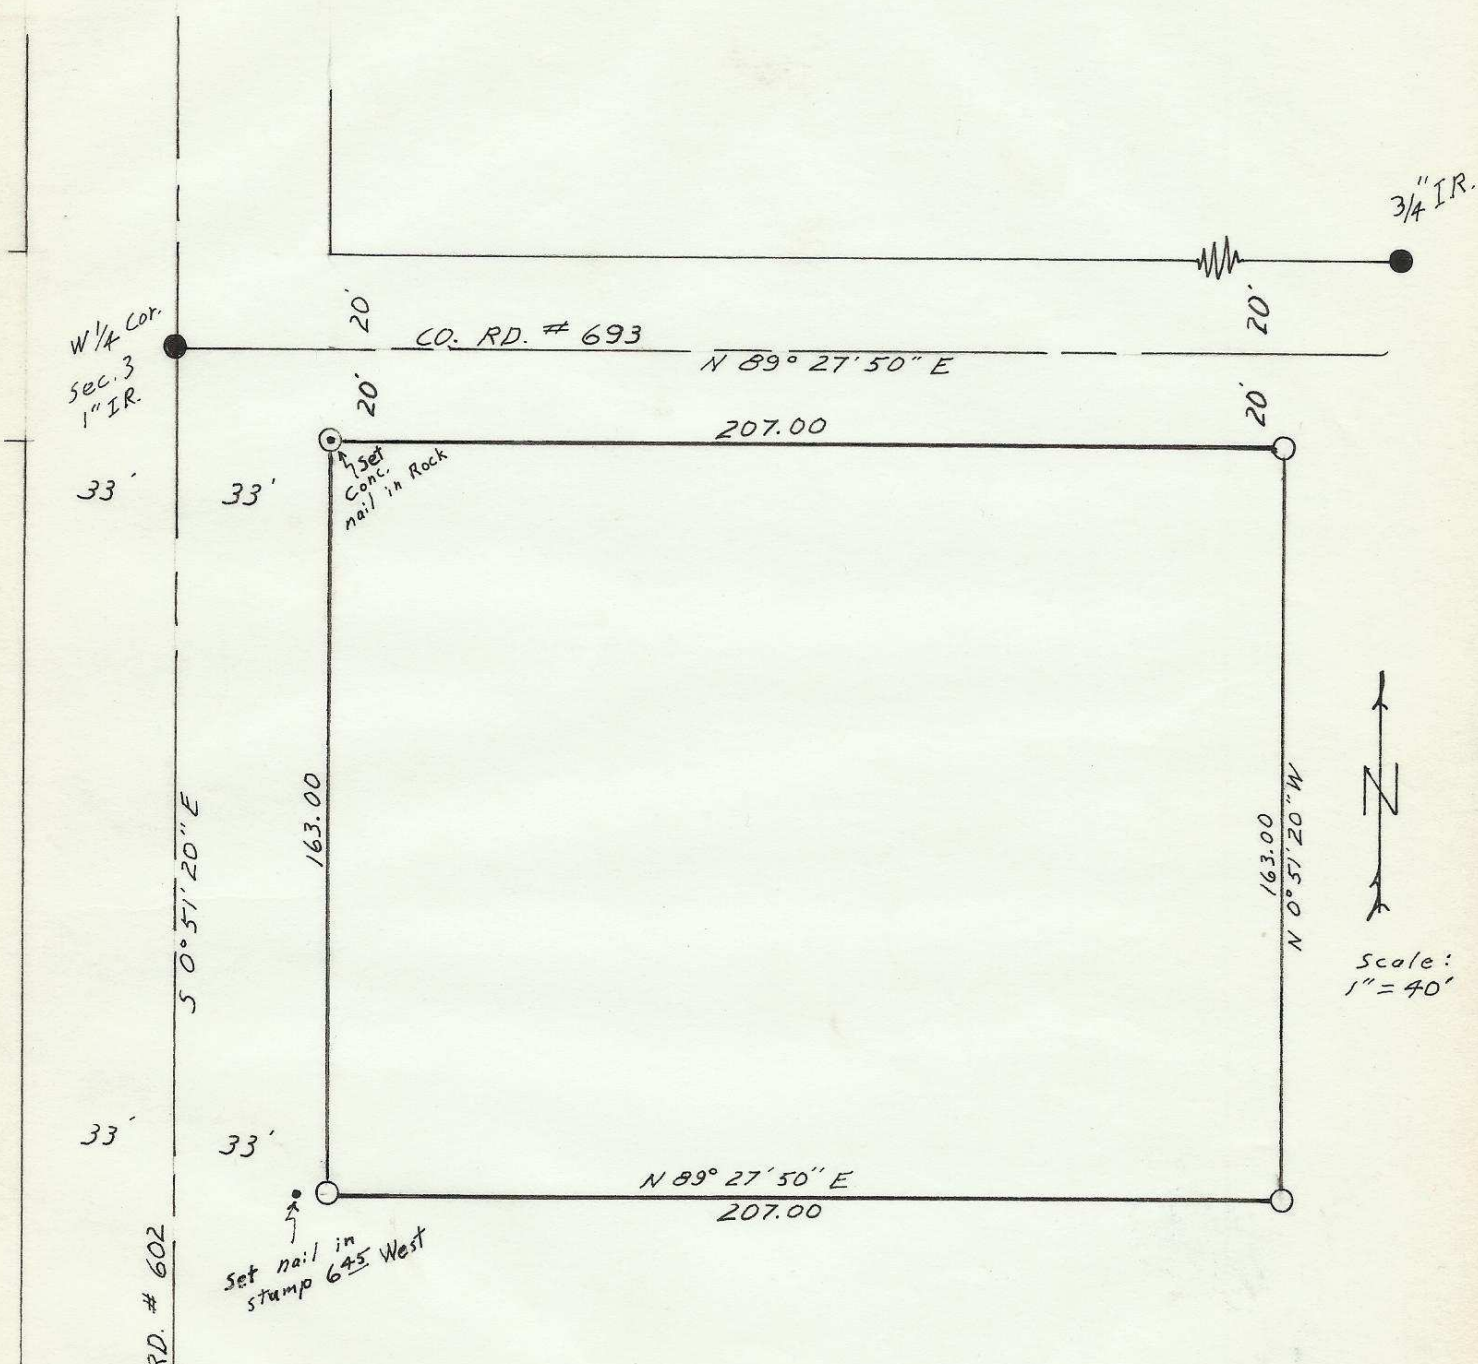

Bearings are based on a 1970  
 WAYNE HARRIS CO. survey

- monuments Fnd.
- 1/2" Iron Rods Set

REGISTERED  
 PROFESSIONAL  
 LAND SURVEYOR

D. Dennis Edwards

OREGON  
 JULY 15, 1971  
 G. DENNIS EDWARDS  
 951

57512096

K-18 Ax