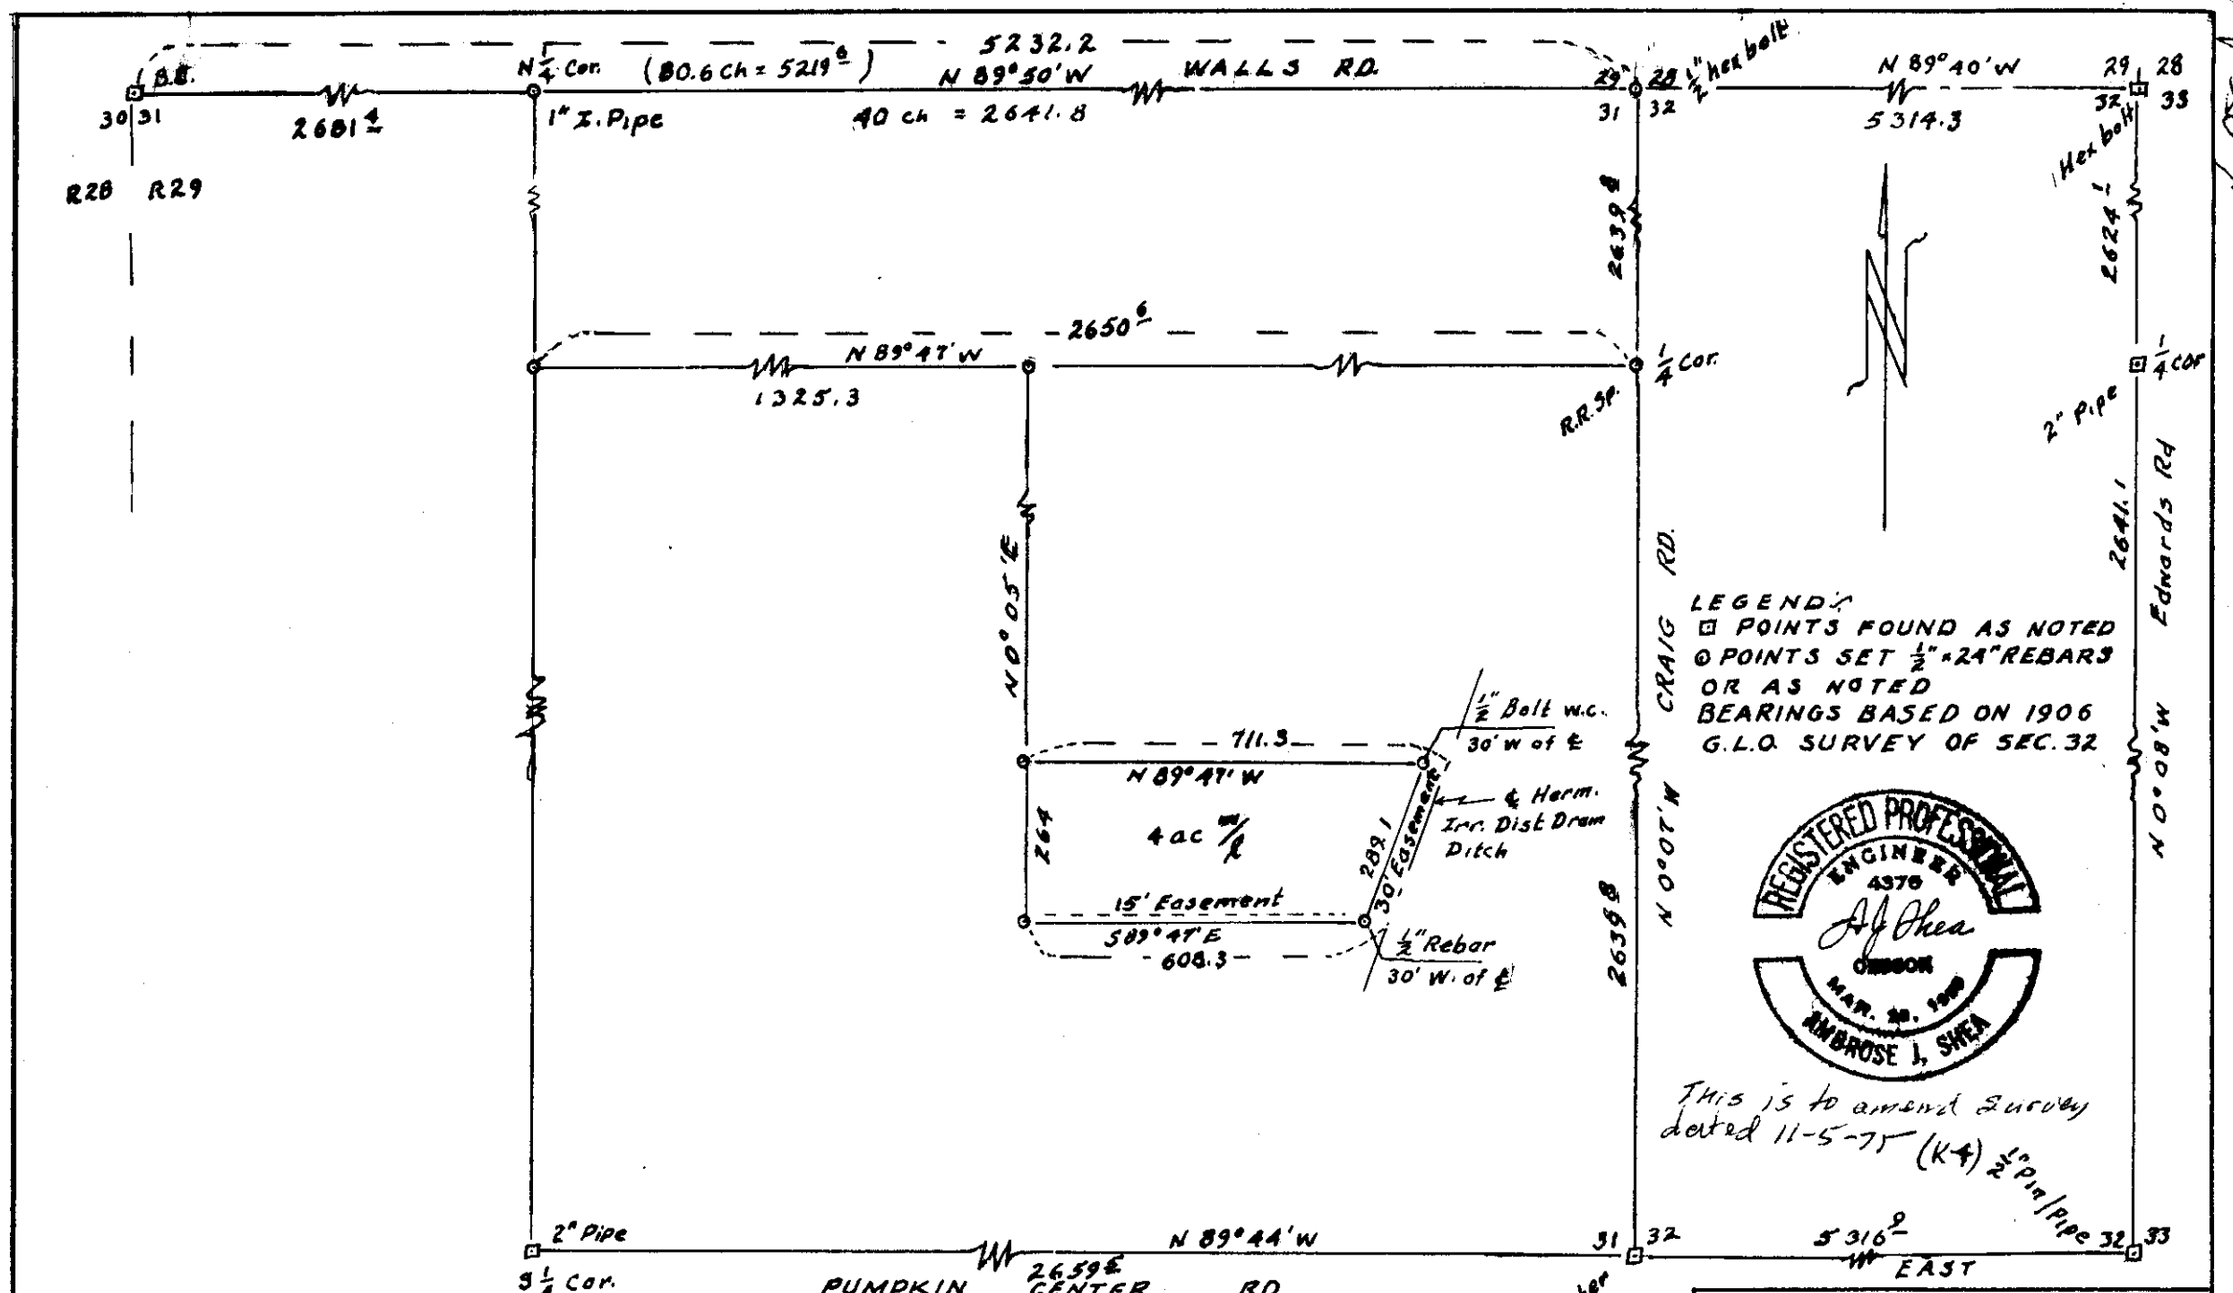

SURVEY PLAT OF TRACT
IN S.E. 1/4 SEC. 31, T 5 N., R 29 E. W.M.
UMATILLA CO.
FOR PETE FORCADE
SCALE 1" = 300' 2/4/76

K-28