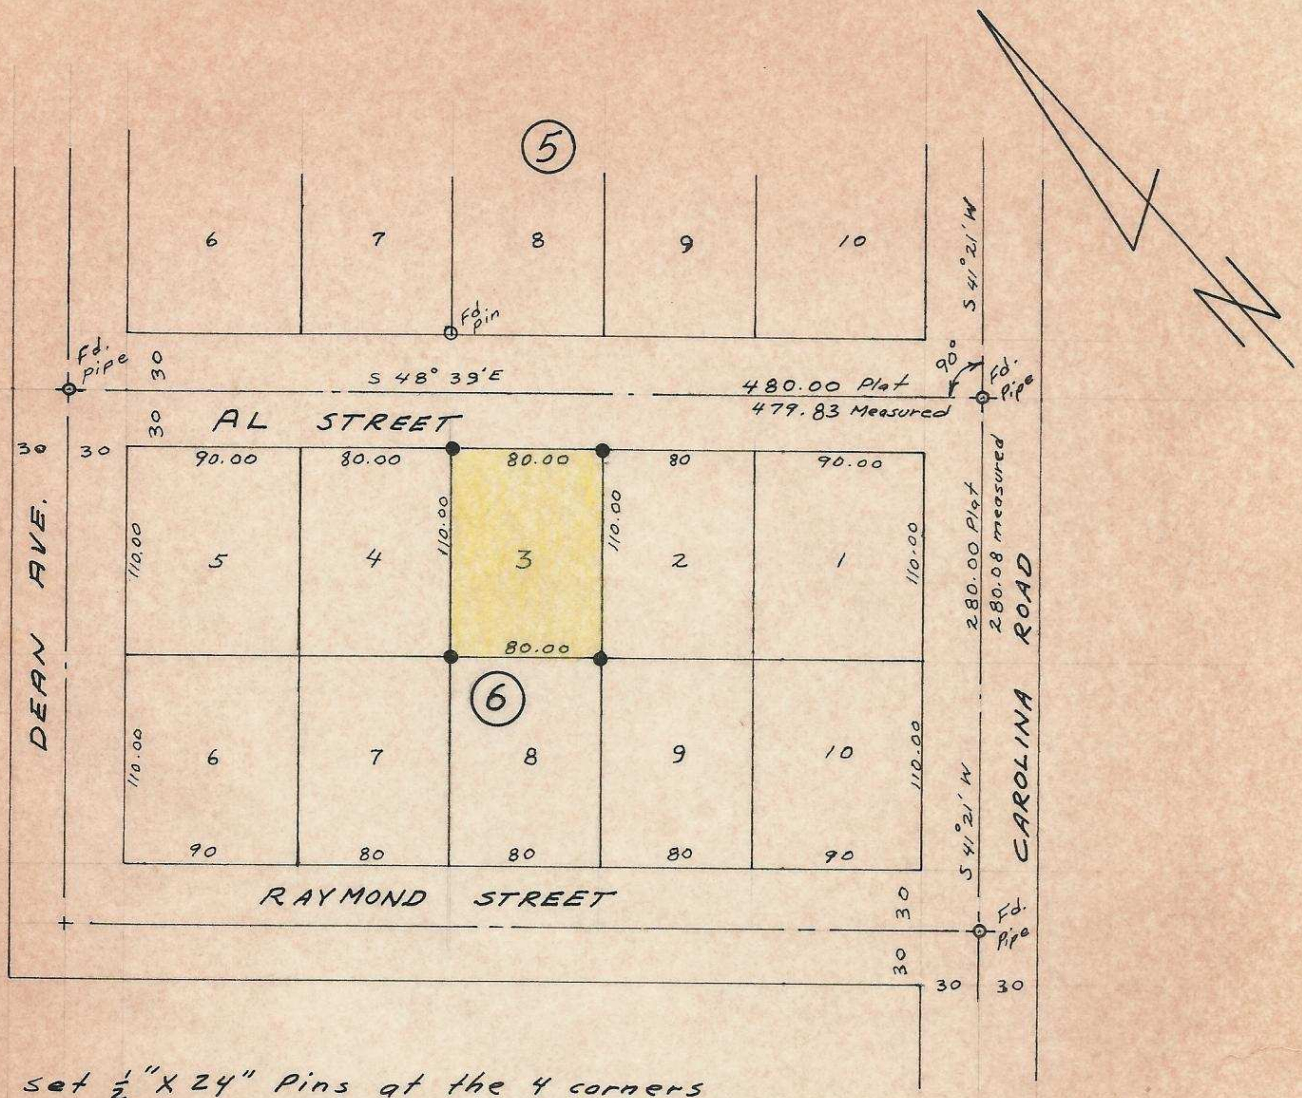

set ½"X 24" Pins at the 4 corners of Lot 3, Block 6 in PETERSON ADDITION in the N.E. ¼, S.E.¼, Section 18 T 5 N, R 28 E.W.M.

REGISTERED PROFESSIONAL ENGINEER 5408 Donald L. Staebler OREGON JULY 9, 1965 DONALD L. STAEBLER

L-77

SURVEY of LOT 3, BLK 6
PETERSON ADDITION
FOR JERRY MOORE, JR.
232 AL STREET
UMATILLA, OREGON

SCALE 1" = 100' | SEPT. 22, 1976

NORPA DEVELOPMENT
P.O. BOX 126
HERMISTON OREGON

L-77-A x