


Q-93-A1

• Denotes 1/2" Iron Pin Set

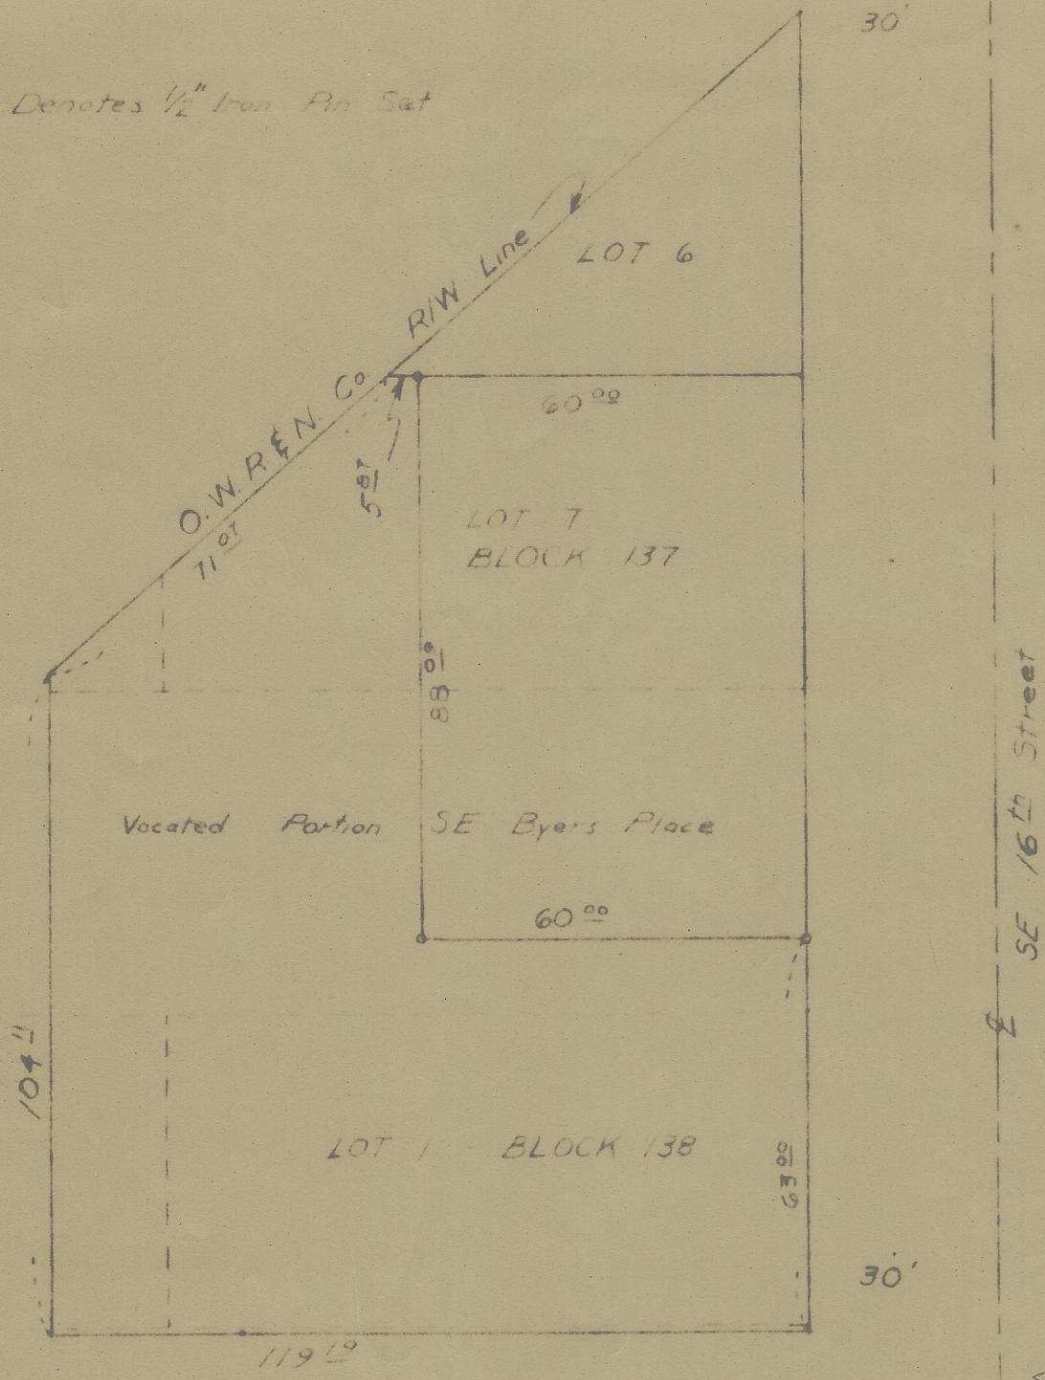

Wayne C Harris

HAYES AND HARRIS

SURVEY FOR

LAWRENCE CARLY

Q-93-A1

PARCEL IN BLOCKS 137 & 138
RESERVATION ADDITION

236

SCALE	DATE	DRN. BY	PLAT. NO.
1"=30'	4/10/62	L.H.A.	62-165

0259