


35-A

N. W. FURNISH

N. W. SIXTH

N. W. EIGHTH

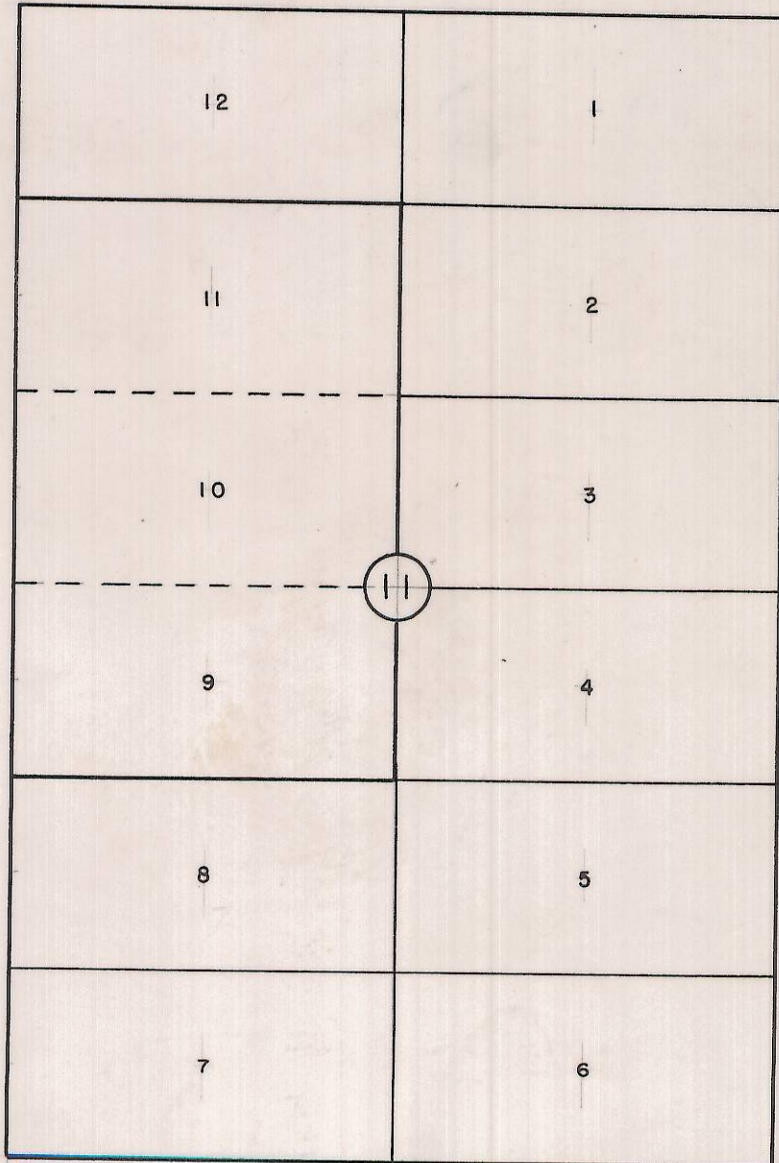

N. W. ELLIS

Q-130-Ax

HAYES & HARRIS ENGINEERING


SURVEY FOR
R. L. WHITFORD

LOTS 9, 10, & 11, BLK II, LIVERMORE ADD'N.
PENDLETON, OREGON

SCALE
1" = 50'

DATE
2-15-55

DRAWN BY
W.O.H.

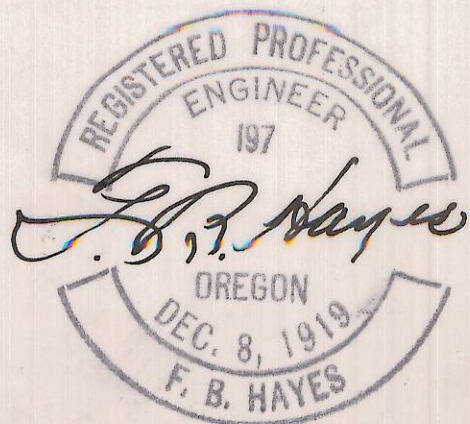

20323DC

Q-130-Ax

35-A