


Q-139-Ax

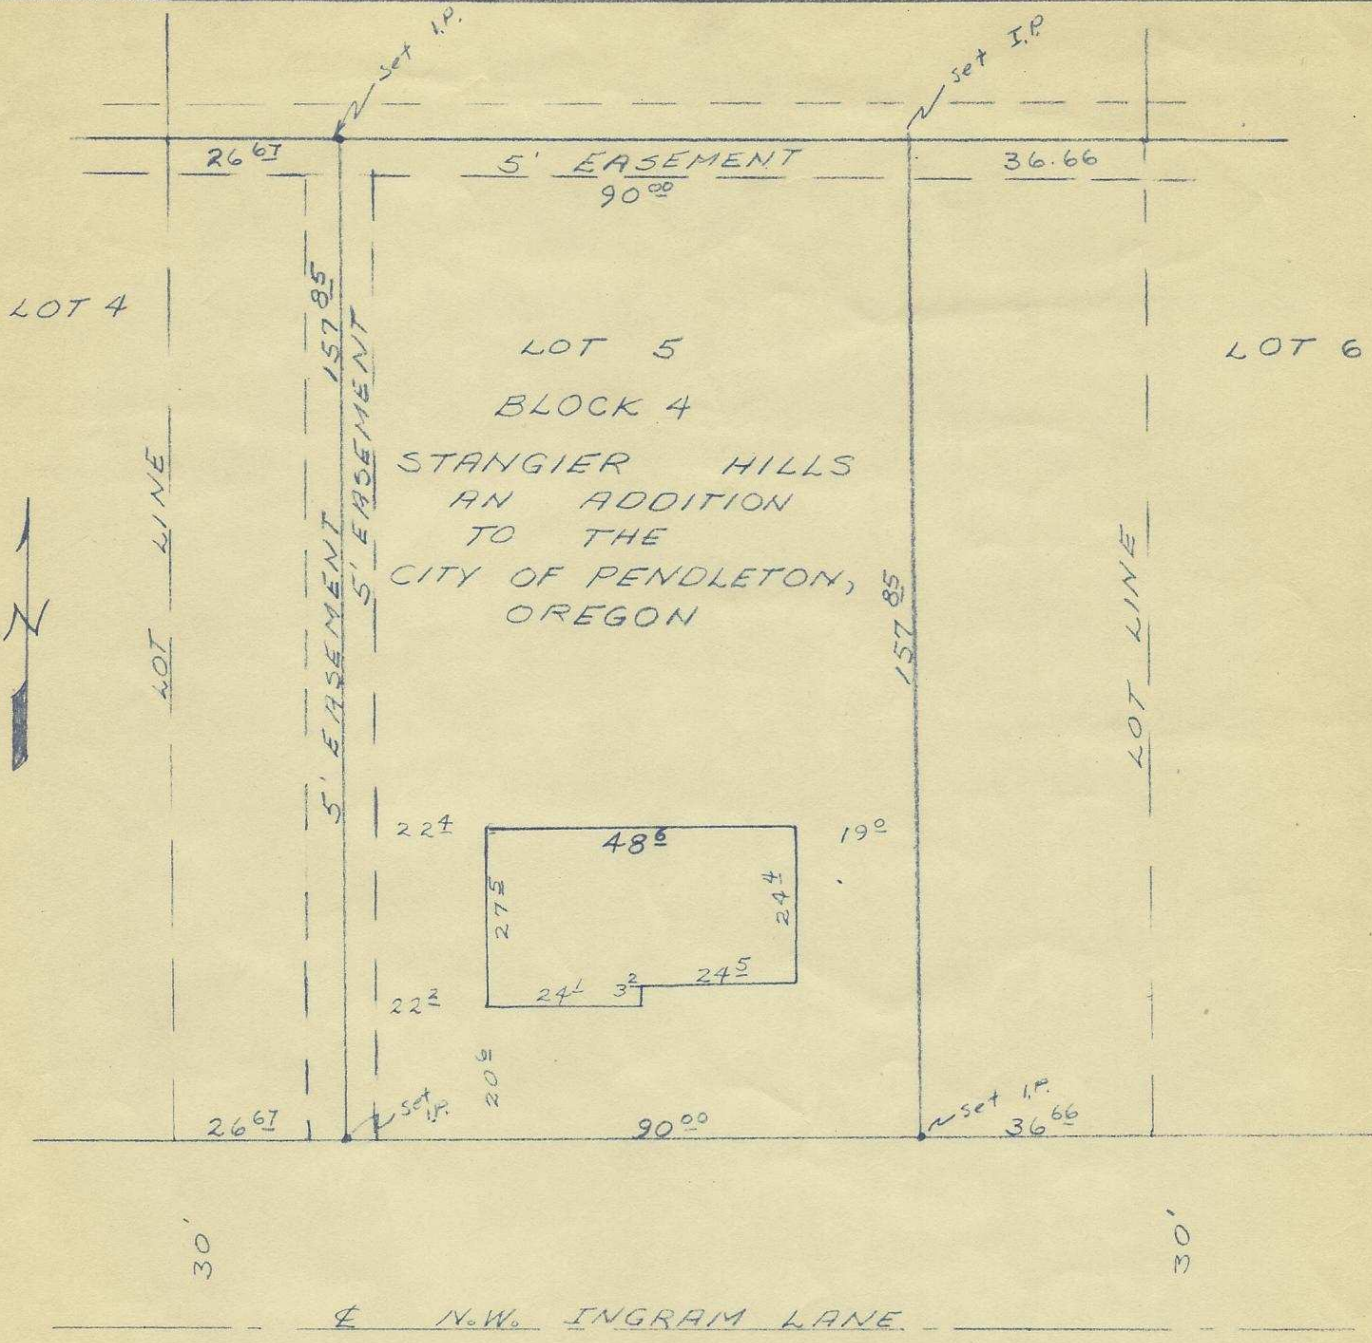

REGISTERED PROFESSIONAL  
ENGINEER  
3758  
*Stanley G. Wallulis*  
OREGON  
OCT. 22, 1954  
STANLEY G. WALLULIS

NW<sup>4</sup> SE<sup>4</sup> (3)

PLOT PLAN  
FOR  
SHERWOOD & ROBERTS

Scale 1" = 30'	DATE: 10-21-58
STANLEY G. WALLULIS Consulting Engineer	
Pendleton Oregon Q-139-Ax 410	