Q-187-Ax

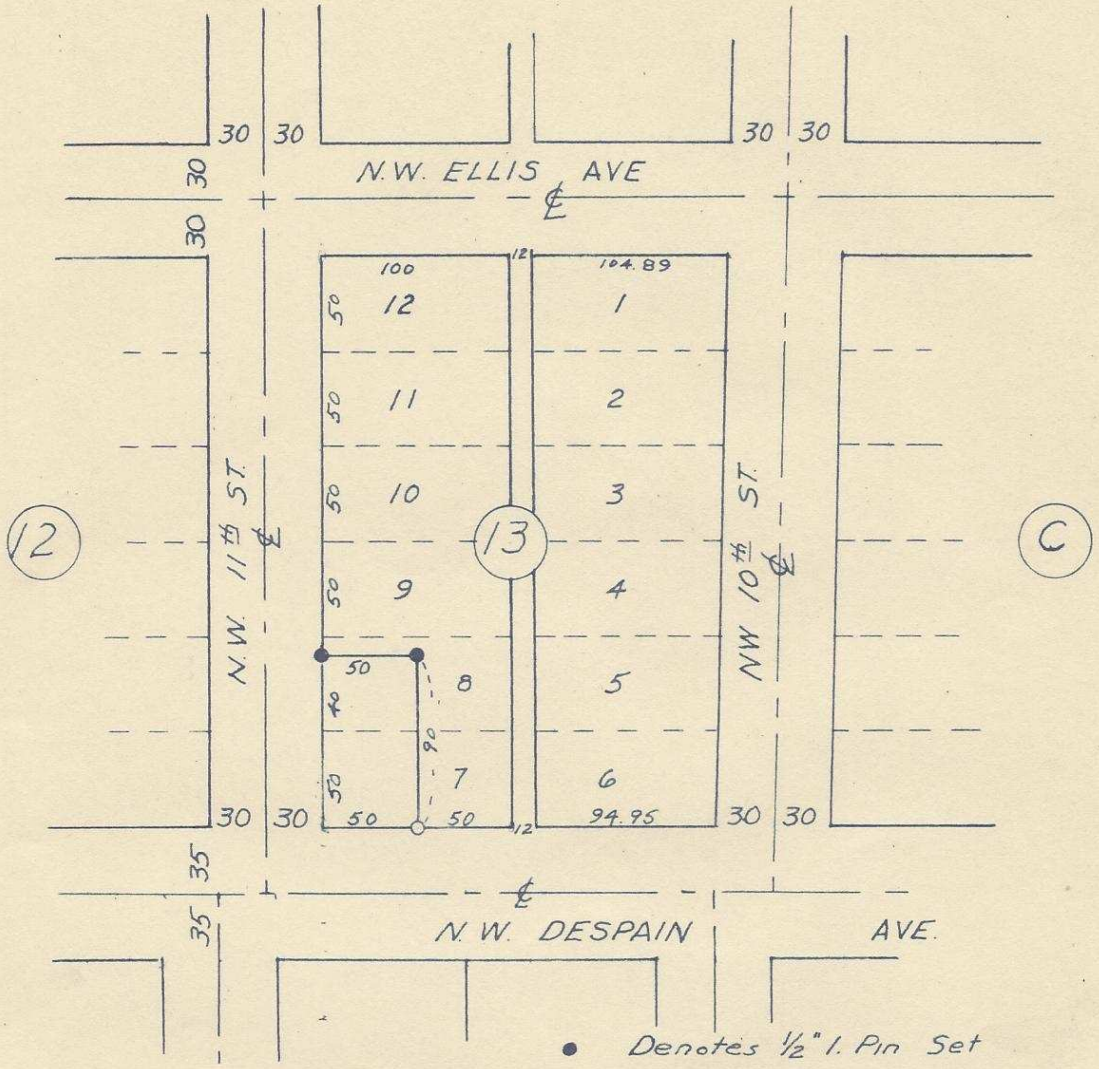

SE¼SW¼ (3)

REGISTERED
OREGON
LAND SURVEYOR

Leland H. Ascher

JULY 10, 1964
LELAND H. ASCHER
635

HAYES AND HARRIS

SURVEY FOR

ROBERT BOND Q-187-Ax

W½ LOT 7 & W 50' OF S 40' LOT 8
BLOCK 13
COLE'S ADDITION, PENDLETON, OREGON

SCALE	DATE	DRN BY	DRNG. NO.
1"=100'	3-28-65	LHA	65-209

A-18