


99

RESERVATION
ADDITION
TO THE CITY OF
PENDLETON, ORE.

S.W. 17TH ST.

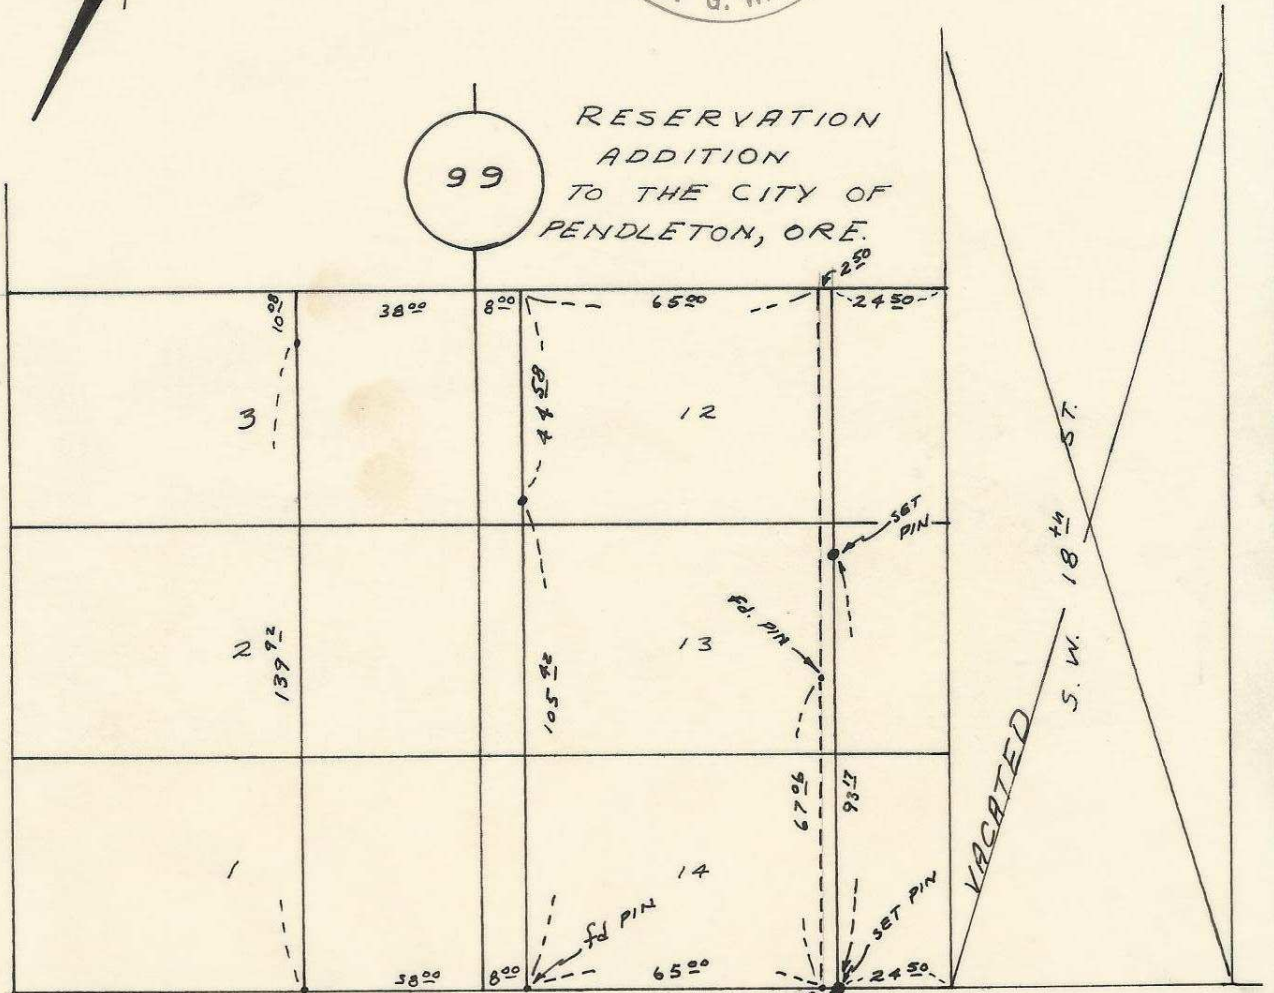

S.W. 18TH ST.

VACATED

30.00

SW FRAZER

LOT SURVEY FOR
WILLIAM A. DIETZ

Scale: 1" = 40'

DATE: July 31, 1962

STANLEY G. WALLULIS
CONSULTING ENGINEER
P.O. Box 91
PENDLETON OREGON

Q-283 AX