




- BRASS CAP SET
- RES. ADD. MON
- TRAV. STA
- DIST. MEASURED

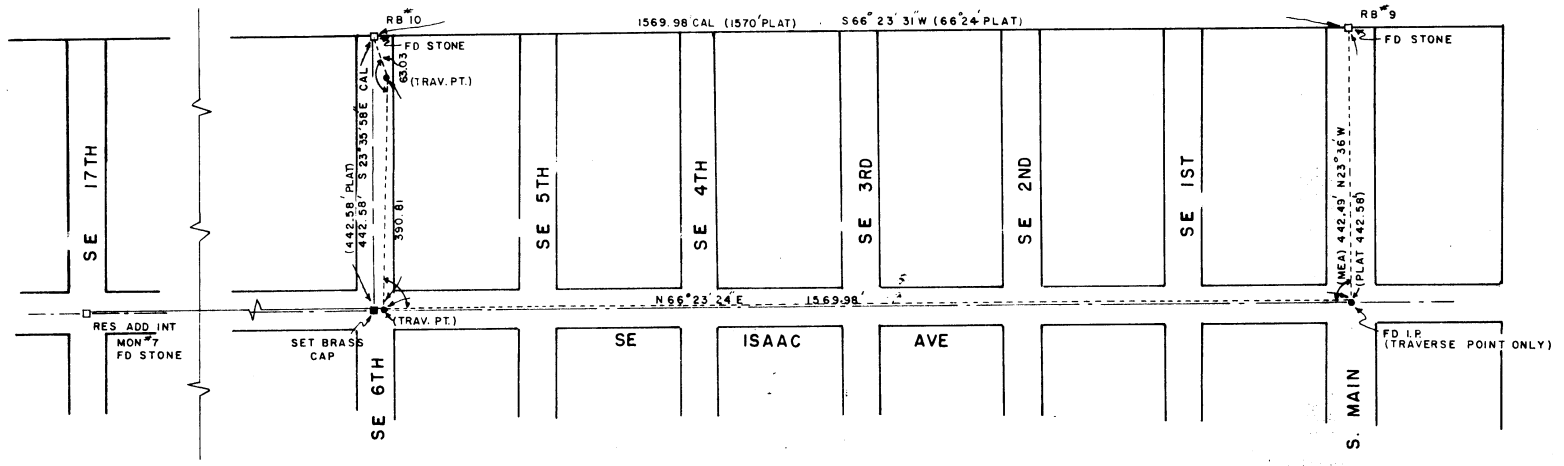

REMONUMENTION FORM (R 6-7100-57) FILED WITH COUNTY SURVEYOR

SE 6TH & ISAAC  
CONTROL SURVEY  
DATE: 6-17-70 SCALE: 1"=200'

11-7664

N 112 H.  
24 32 C