


S.E. COURT PLACE

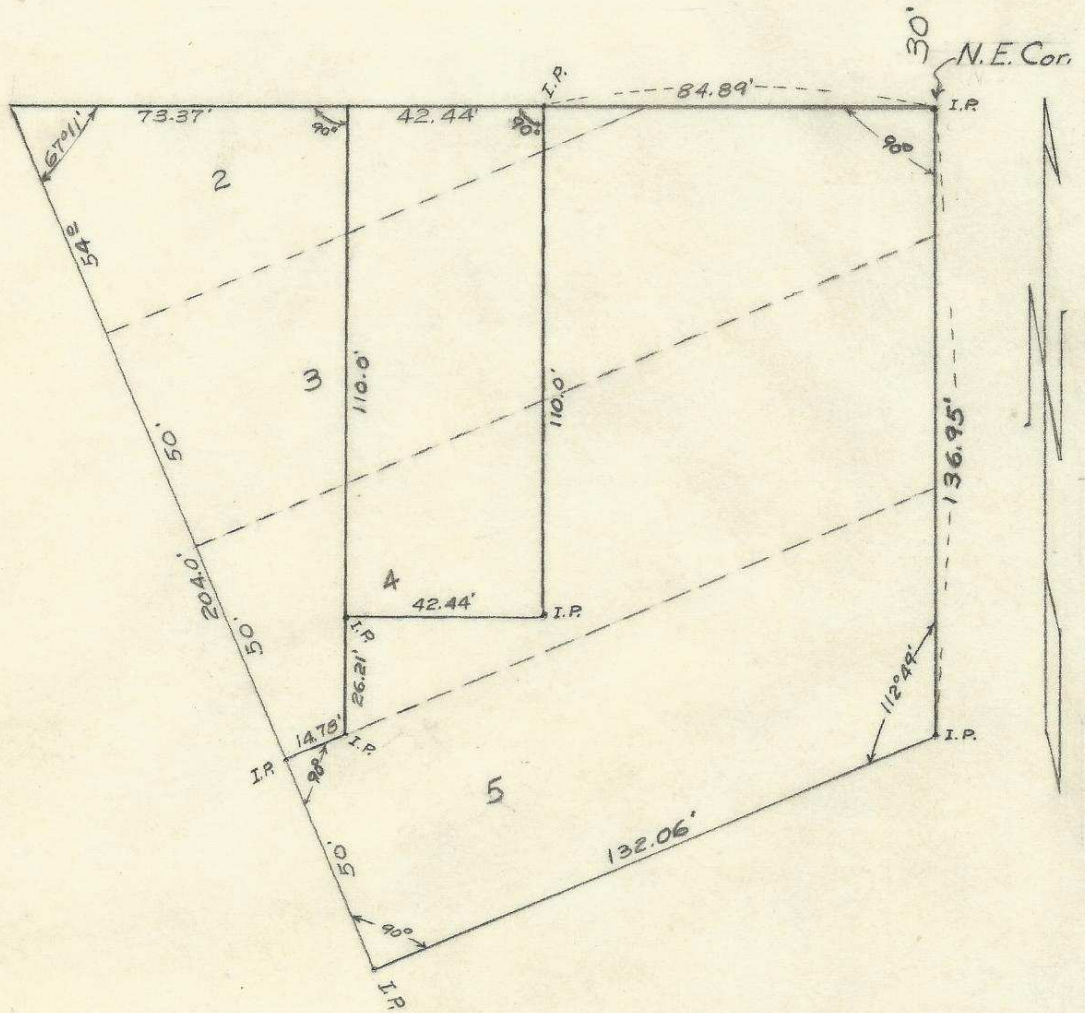

Q-341-Ax

REGISTERED
OREGON
LAND SURVEYOR

Wayne O. Harris

MAY 6, 1955
WAYNE O. HARRIS
346

T2N R32 11 AB

HAYES & HARRIS ENGINEERING

Survey For

EDWARD & NIETY R. JOHNSON

Parcel of Lots 2, 3, 4 & 5, Block 64

Reservation Add'n, Pendleton, Oregon

Scale	Date	Drn. By	Drng. No.
1" = 40'	8/9/56	A.B.Y.	33