


G-371-AX

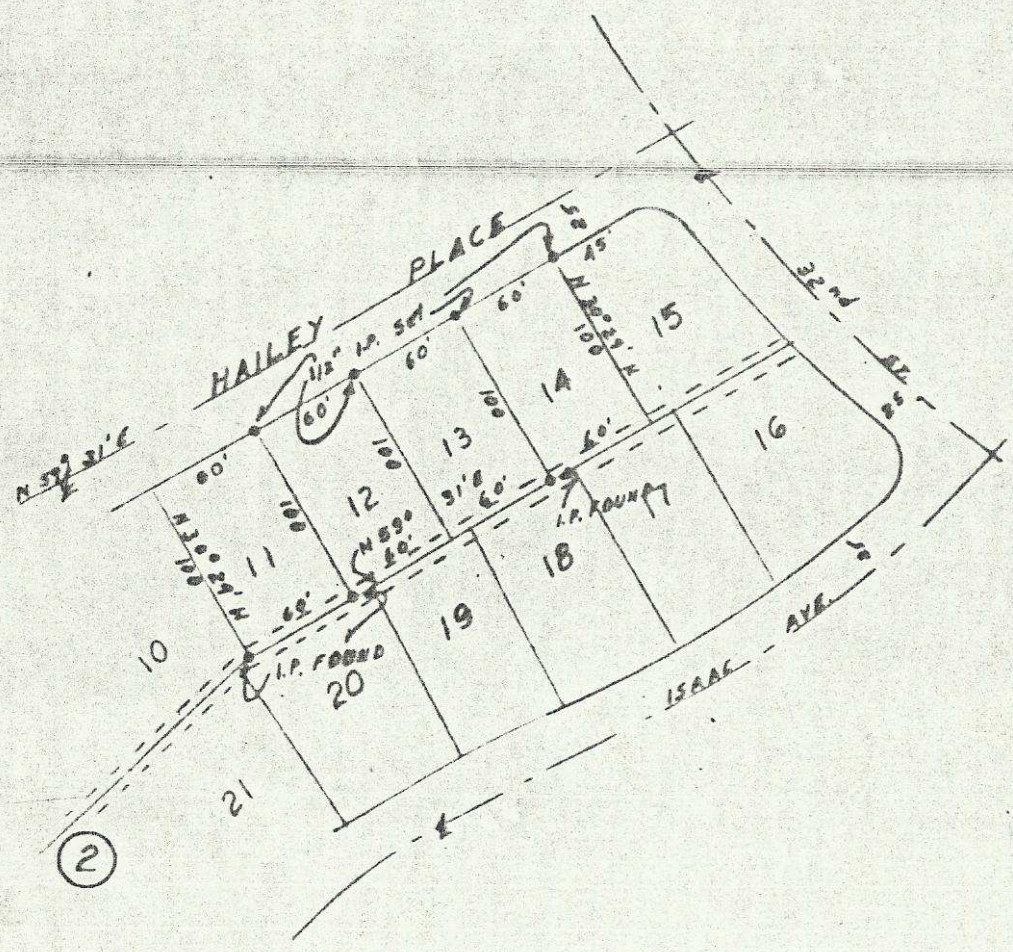

SE <sup>16</sup> 16

16BD

Wayne O Harris

HAYES AND HARRIS			
Survey For			
CANNADY CONST. CO.			
Lots 12, 13, & 14, Block 2			
CRESTVIEW ADDITION			
PENDLETON, OREGON			
Scale	Date	Drn. By	Drng. No.
1"-100'	11/1/58	WOH	58-71

G-371-AX  
400