



Amo XA-CX-5-D

①  
J. Bragotti

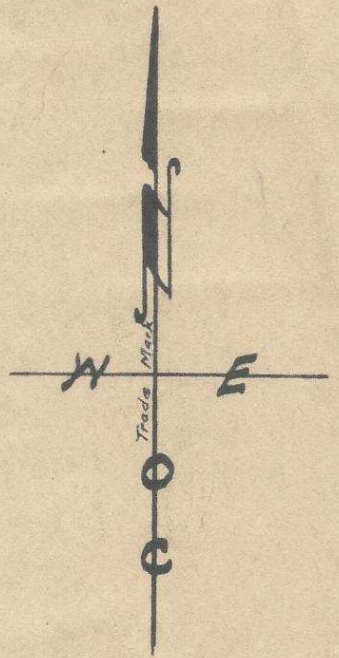

5217<sup>04</sup>

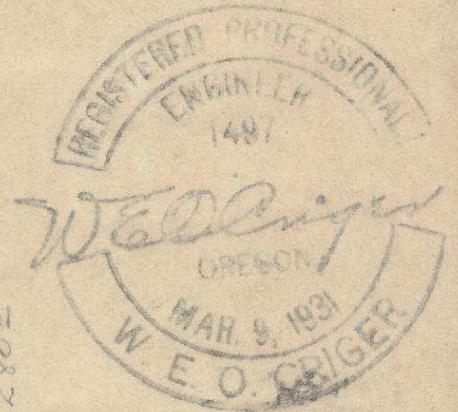

52802

J. Bragotti

⑫ 26092

Map of  
Sec's 1 and 12 - T.3N, R36 E. WM.  
Showing lands owned by  
J. Bragotti.  
surveyed, staked & platted  
July - Sept. - 1951 -  
By W. E. O. Criger.  
Scale: 1 inch = 1000 Ft.

52202