


Q-528-Ax  
557

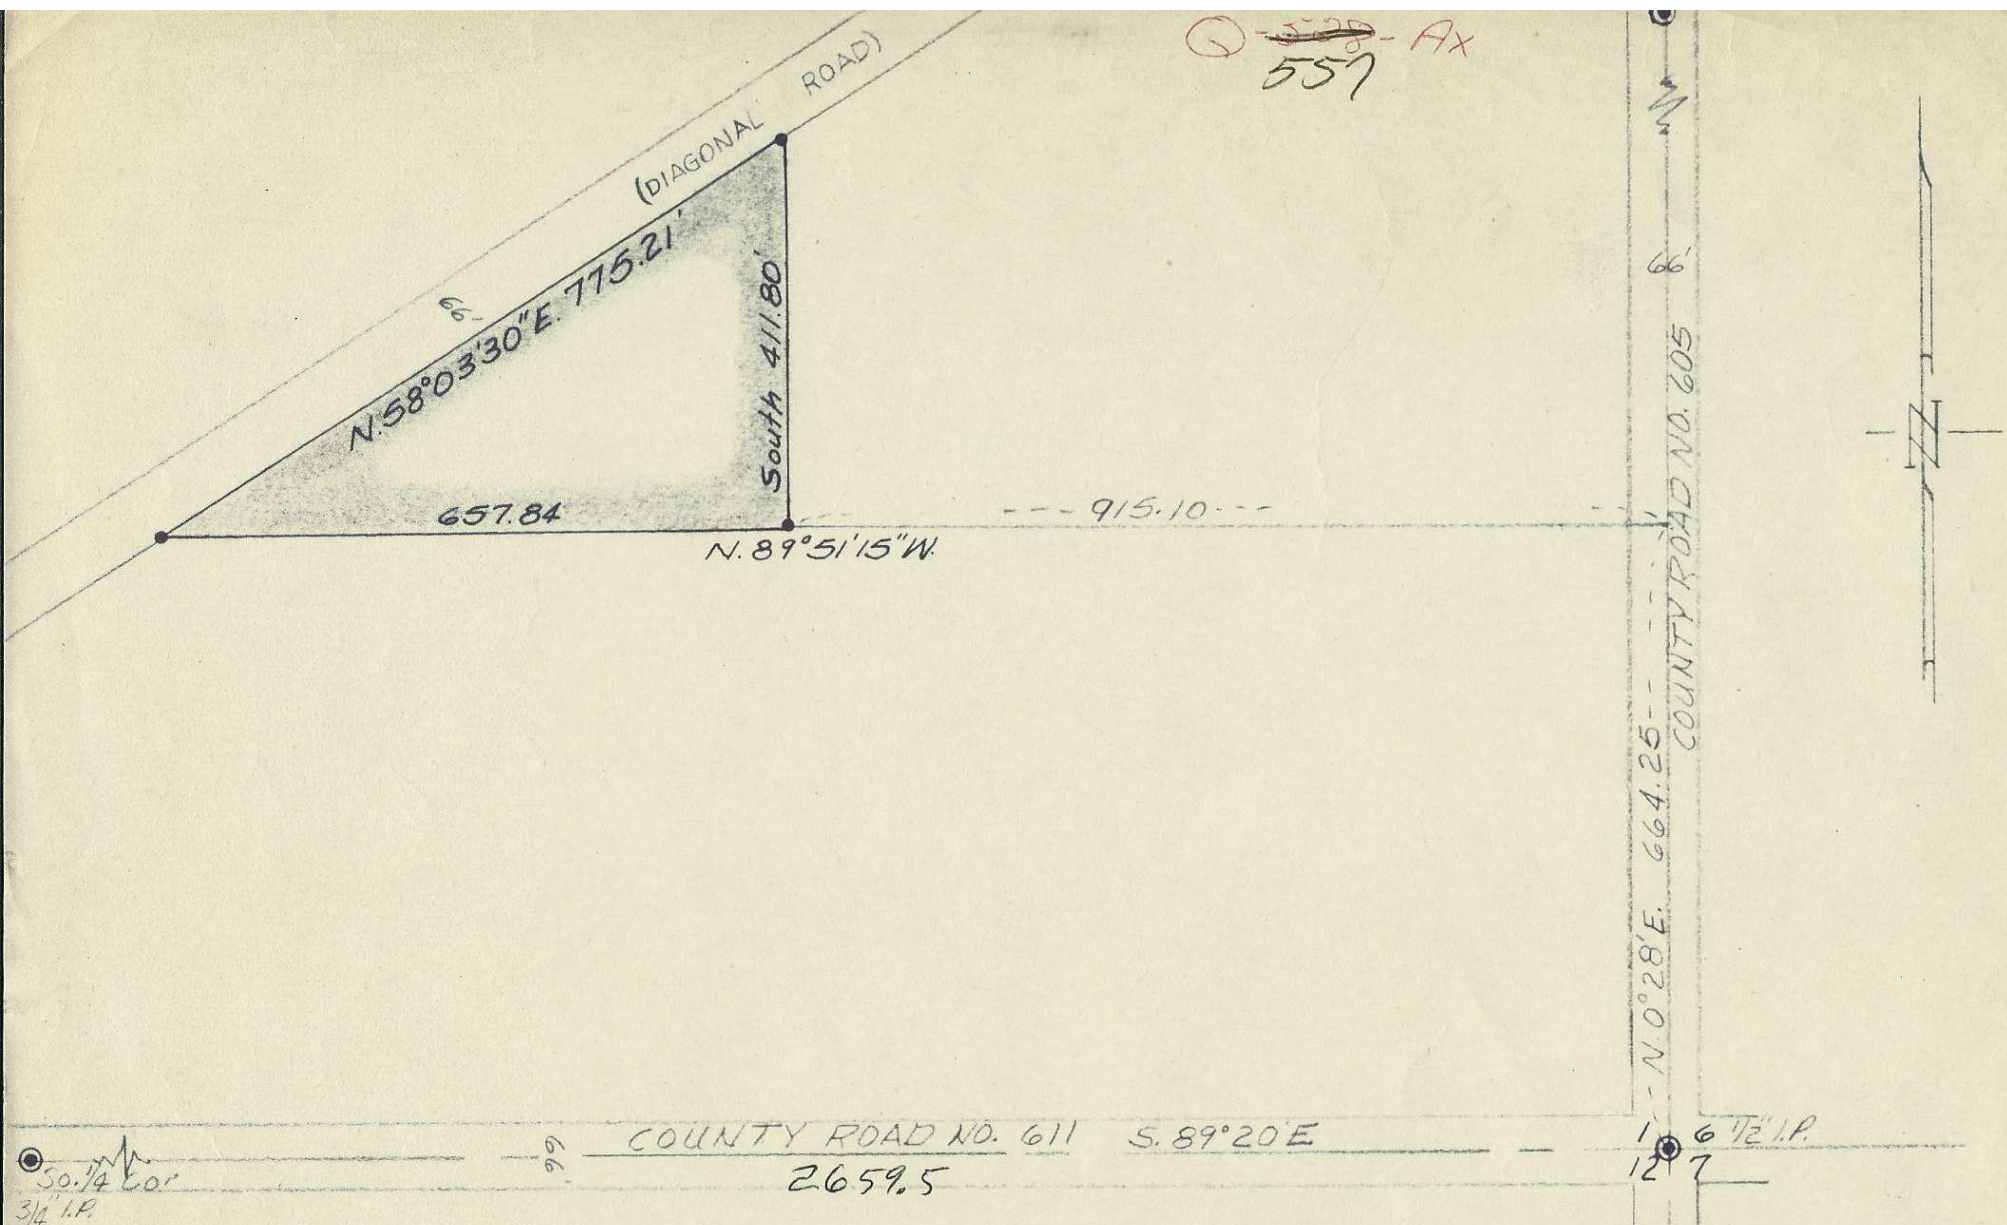

REGISTERED  
OREGON  
LAND SURVEYOR

Ralph P. Thompson

MAY 13, 1960  
RALPH P. THOMPSON  
506

"•" Indicates Iron Pins Set  
"⊙" Indicates Monuments Found

SURVEY FOR <b>AH. ROSENBAUM</b>	
In S.E. 1/4 Sec. 1, T. 4 N. R. 28 E. W.M.	
Date: 10-30-63	Scale: 1"=200'
Ralph P. Thompson Land Surveying 13 S.E. Court Ave. Pendleton, Ore.	

619