


Q-798-A

Q-798-A

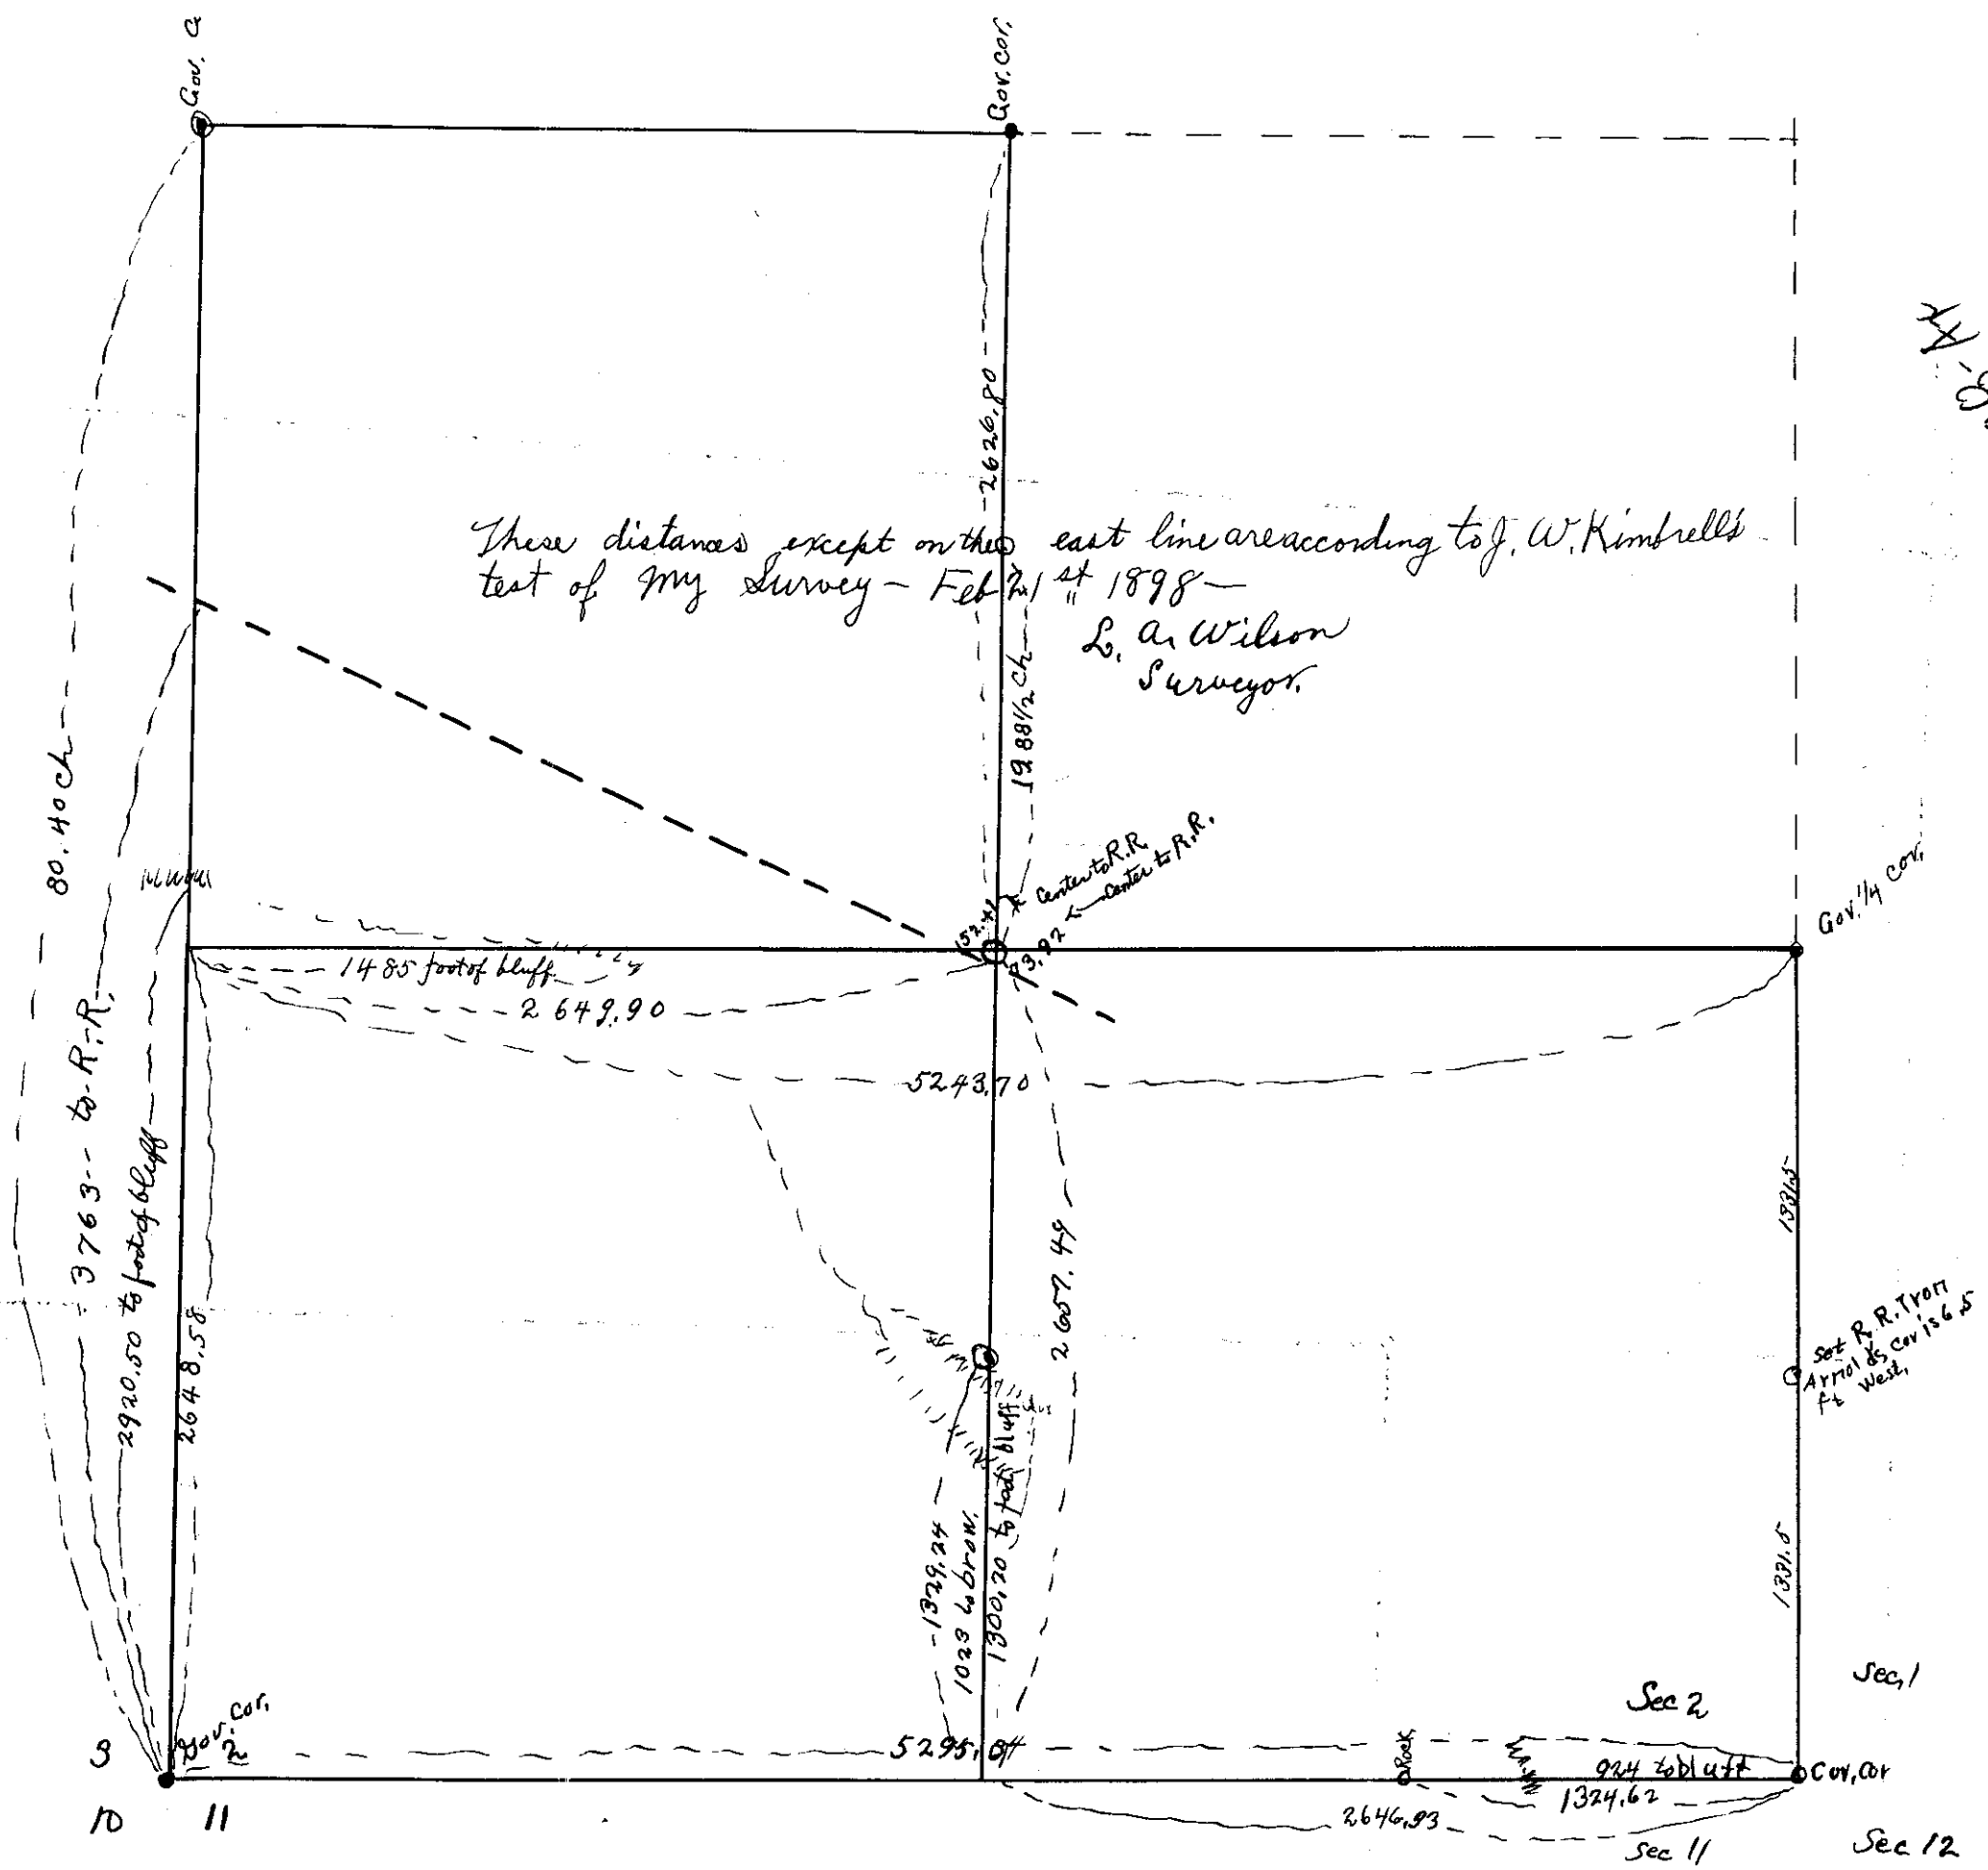

These distances except on the east line are according to J. W. Kimbrell's
 test of my Survey - Feb 21st 1898 -
 L. A. Wilson
 Surveyor.

Set R. R. from
 Arrival of Cor is 6.5
 ft West

Q-798-Ax