


Q-842-Ax

Q-842-Ax

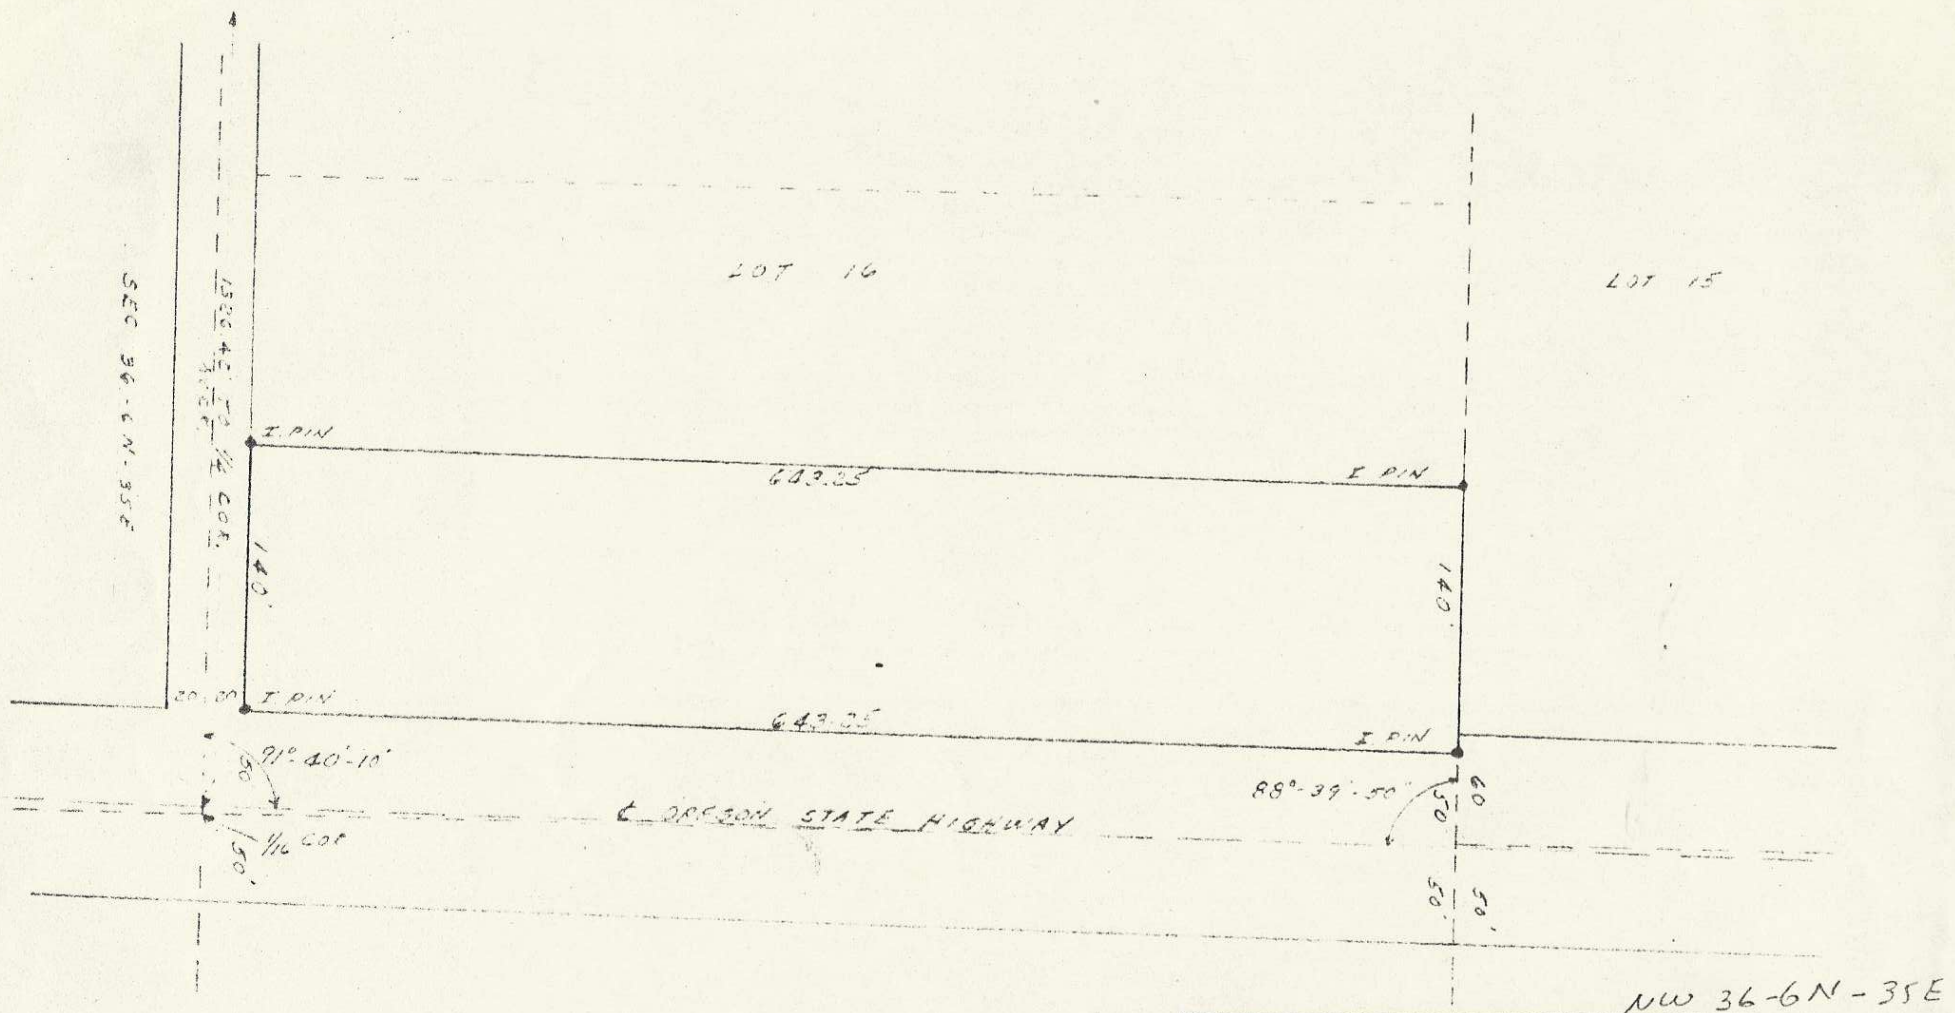

STATE OF OREGON
 LAND SURVEYOR
 G. M. NEWBILL
 255
 MA. 6. 1940

SCALE 1" = 100'

G. M. NEWBILL	
LICENSED LAND SURVEYOR	
17 N. Second	Walla Walla, Wash. Phone 4170
Surveys	A SURVEY
Descriptions	FOR M.H. GROGAN
Sub Divisions	IN LOT 16 LOUNDAGIN TRACT
Date	2/15/57
Drawn By	G.M.N.
No.	123