


50 Q-985-Ax


NW 12 BE

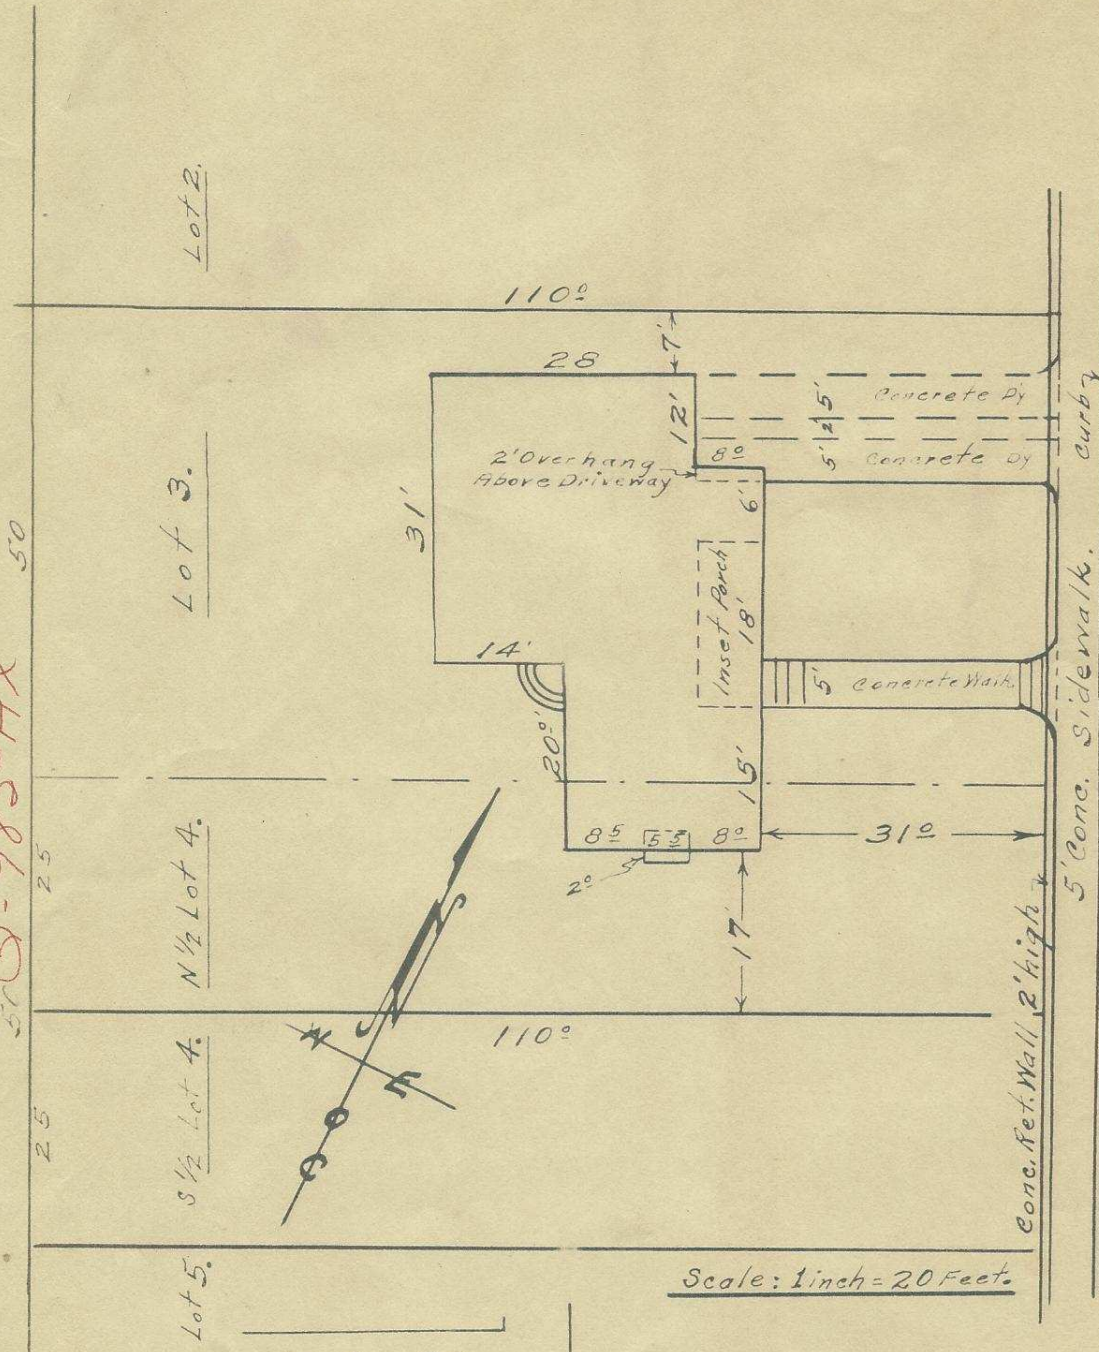

Scale: 1 inch = 20 Feet.

COLLEGE ST.

Natural Soil and gravel.
sewer line & Water Main Installed.

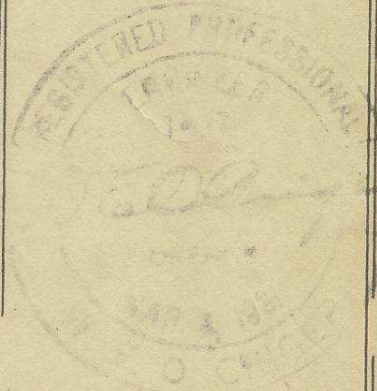

I hereby certify that I have carefully surveyed and located the building and other structures of improvement upon the ground, in their true and correct position, as shown on the above plat.

W. E. Origer

