

T.15.R.32

12
13
(209.2)

G-878-AX

East (8910.00) 989

7 8
18 17

18 (990.0) (1320.00) (1320.00)

(1314.7) (1315.4) (1316.4) (1317.0)

5 4 3 2 1

(993.9) (1320.00) (1320.00)

(1314.7) (1315.4) (1316.4) (1317.0)

6 7 8 9 10

(994.9) 1320.00 1320.00

(1314.7) (1315.4) (1316.4) (1317.0)

17 16 15 14 13

1001.9 1320.00 1320.00

(1314.7) (1315.4) (1316.4) (1317.0)
















End. Charred Post, Mnd. Stones 409.5

N. 0.25' E. 1314.7

(429.0) 1314.7

End. Rock Jack on line

T.15.
R.35
18
E.M.R.

UTMA RESERV. Boundary

South (5280.00)

REGISTERED OREGON LAND SURVEYOR

Ralph P. Thompson

MAY 13, 1960 RALPH P. THOMPSON 506

Property Survey For ELSIE M. ROSS lots 3,4,5,6,7,8,15,16, Sec. 18, T.15 R.35

Date: 5-21-63 Scale: 1"=1000'

Ralph P. Thompson Land Surveying Pendleton, Ore.

1151 "Indicates Iron Pins Set Distance Shown Thus (1320.00) Are G.L.O. Distance Shown Thus 1320.00 Are Measured

WEST PORTION OF SECTION 18 T.1 S.R.33 E.W.M.

OBJECT: To locate the South line of lots 6,7,8,15,16, The West line of lot 16 and the East line of lot 15, all in Section 18,T,1S.R.33 E.W.M.

MONUMENTS FOUND:

THE west 1/4 Cor Section 19,T.1 S.R.33, a stone about 8"x10"x18" standing on end, about 10" in the ground, Marked "1/4 C.C." on the East face. a small mound of stones around it.

The S.W. Corner Section 18 T.1 S.R.33 E.W.M, a rock jack with old established fences running North and South and East.

THE S.E. Corner of Section 13 T.1 S.R.32 E.W.M. a rock jack with old established fences running N & S. and West.

The East 1/4 Corner Section 13 T.1 S. R.32 E.W.M. Found a charred post, (bottom part only in the ground) and a mound of stones around it, from which a fence corner bears North 3 ft. and East 2 ft.

The west 1/4 Corner of Section 18,T.1 S.R.33 E.W.M was questioned by a Rancher in the Area. Having found sufficient evidence of corners on the West line of Section 18, I proceeded with the Survey.

FROM THE EAST 1/4 Corner of Section 13 T.1 S.R.32 E.W.M I run S.0°25'W.along the West line of Section 18.

409.5 ft.

Set 1/2" I.P. on N-S fence line, Raised a mound of stones around it, for the WEST 1/4 Corner of Sec.18,T.1 S.R.33; From which a fence corner bears South 5 ft.

997.90 ft.

From the West 1/4 Corner Section 18 I run thence Due East, Set 1/2"x24" I.P. for S.E. Corner of lot 6. Raised a mound of stones around it, from which an E-W fence bears South 4 ft.

Thence Continuing Due East

3637.92 ft.

Set 1/2"x24" I.P. for the S.E. Corner of lot 3. Raised a mound of stones around it, from which a four way fence corner bears

South 9 ft. and East 41 ft.

FROM THE WEST 1/4 Corner Section 18 T.1 S.R.33 EVM I run S.0°25'W.
along the West line of said Section 18.


1314.7 ft. Temporary Corner for the S.W. Corner of lot 17, from which I run
Due East.

1001.9 Set 1"x40" I.P. in wheat field with a 6 ft piece of channel Iron
along side of it, from which a 36" walnut tree and fence corner
bears North 25 ft. and East 3 ft. Thence Continuing Due East.

3641.88 Set 5/8"x30" I.P. and raised a mound of stones arround it, from
which a N-S fence bears East 2.5 ft.

Land was steep and rocky, line was run with a K&E Transit, with
a one minute vernier reading having a 6 1/2" Horizontal circle.
Distance was measured with a 300 ft. steel tape. Temperature
averaged 60°, a slight breeze occasionally but no strong wind.

Ralph P. Thompson 5-21-63
Ralph P. Thompson L.L.S. #506

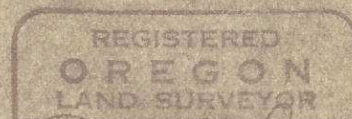

Ralph P. Thompson
MAY 13, 1968
RALPH P. THOMPSON
506