


Changes in lot lines NE-NE 10

BIK 1.
Sherwood Heights.

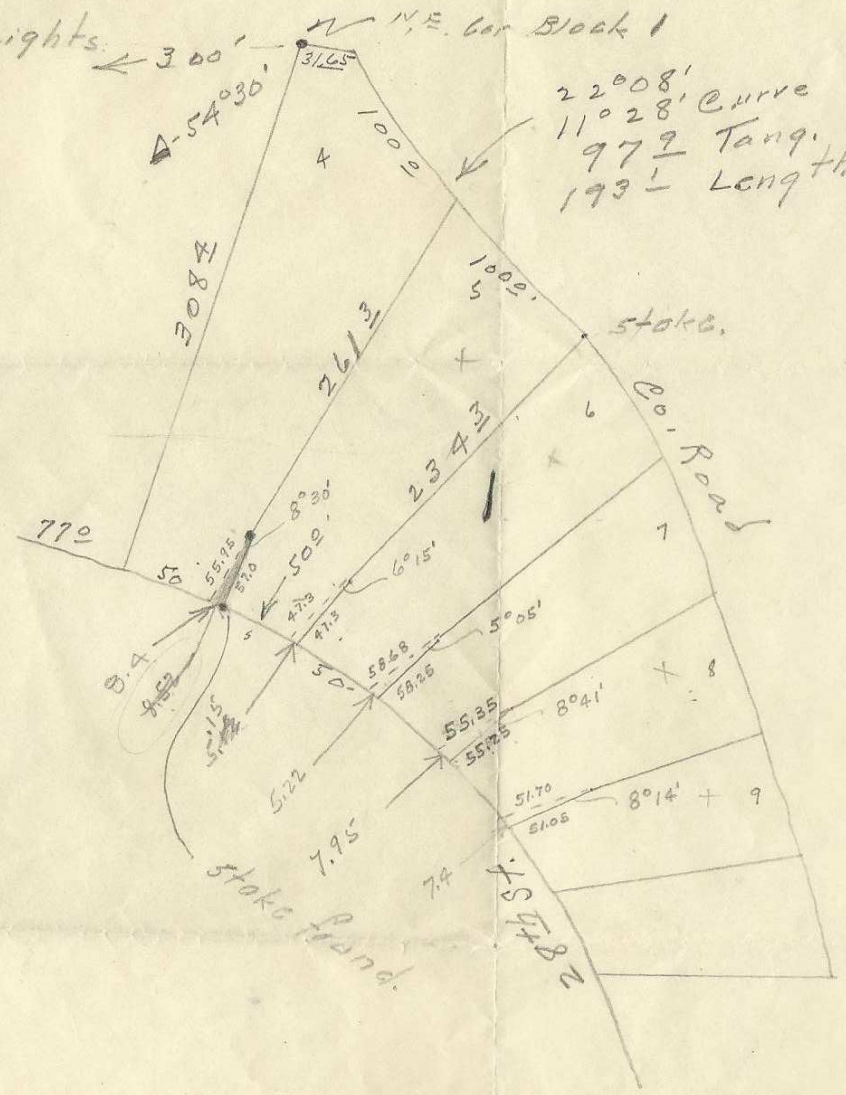

22008' Curve
11°28' Curve
979' Tang.

Keep this to
check against when
instrument is used
Also correct
with this
state

22'

16AA

ORIG

Q-1281-1