


Q-1303

Vernon B. Tenneson & Assoc.  
July 1956 Pendleton, Oregon

SE 1/4 NE 16

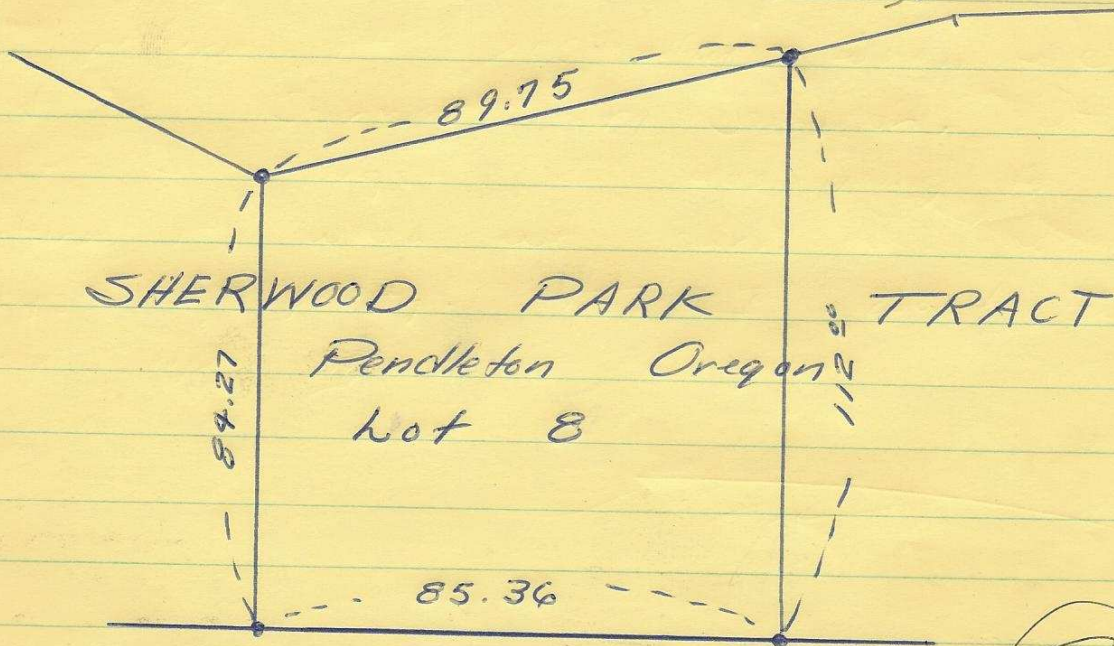


SHERWOOD PARK TRACT

Pendleton Oregon

Lot 8

NYE AVE

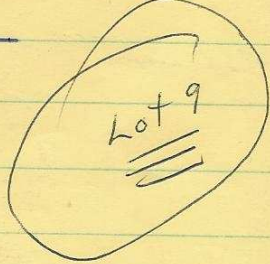

247

B. 3

L. 9

16 AC

