


SURVEY IN SEC. 11, T. 4 N., R. 28 E., W.M.

No Scale.

25289.6  
3043.8

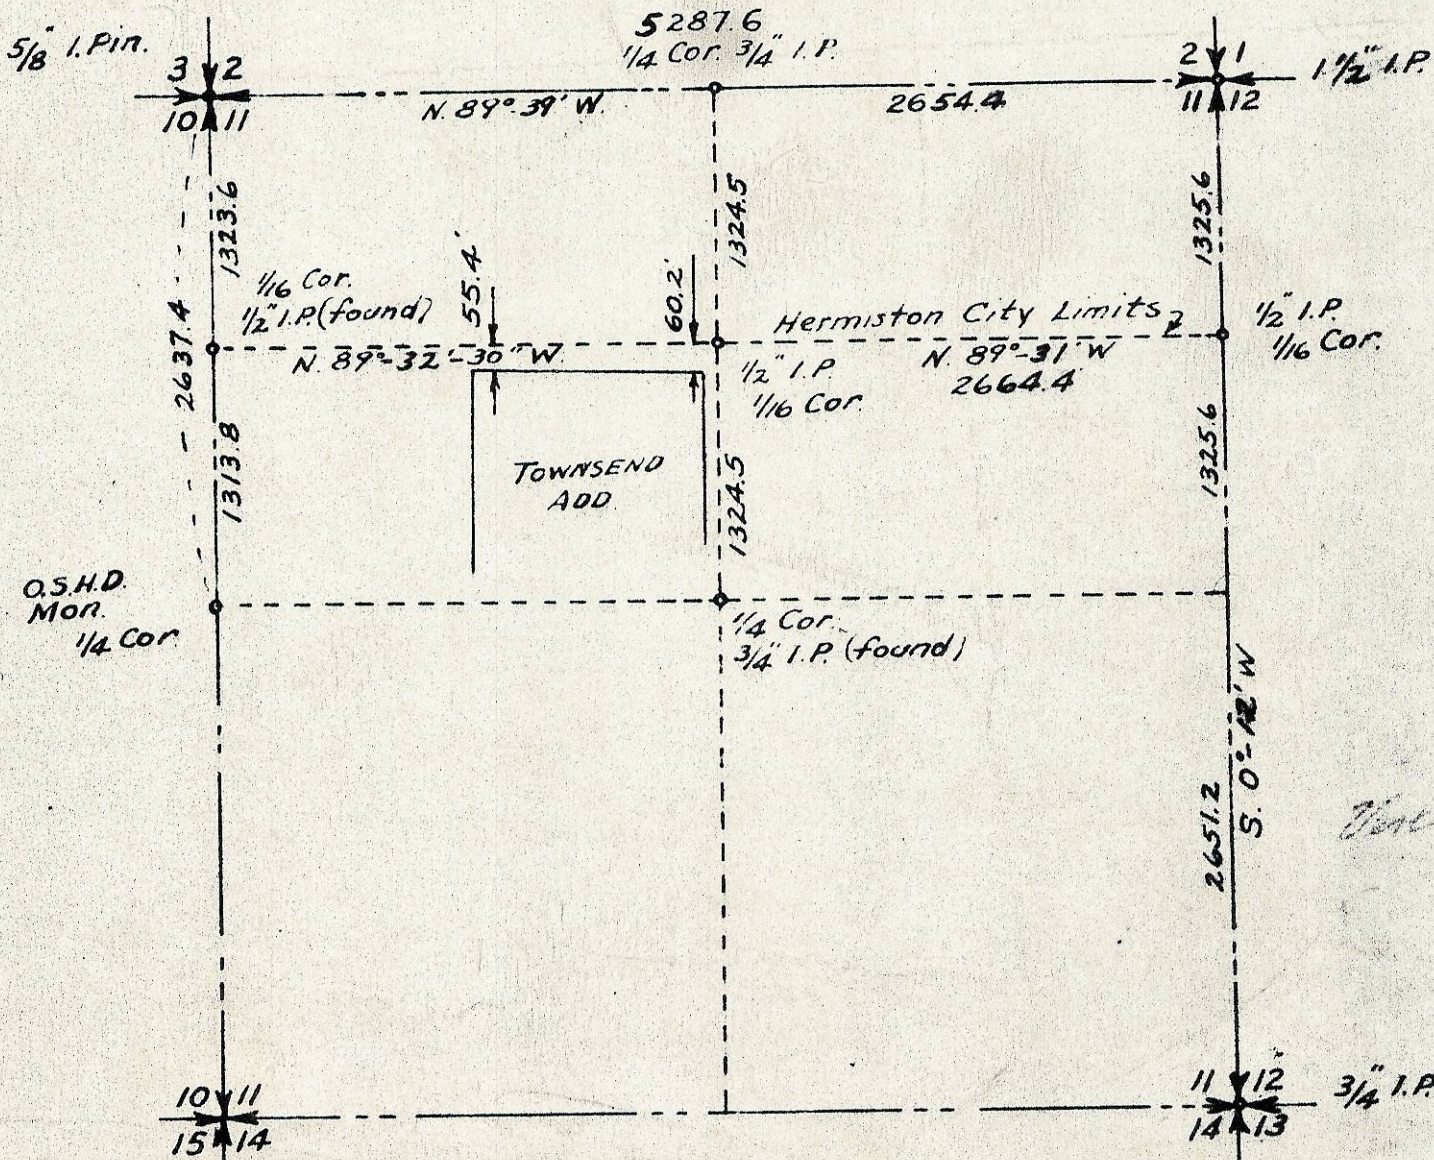

Carl R. Analey  
No. 183

Q-1526-Ax

617