

N. 89°37'W

79.77 ch.

Old Road - Vacated.


Athena
Goldman Rd.

300'
State
of
Oregon.
299 E
5.43°42'W

1282'

Pump Location
Iron Pin 10' E. of Cr. Bank
J.H. Sampson, et ux.

Spring
Iron Pin 10' S. E.

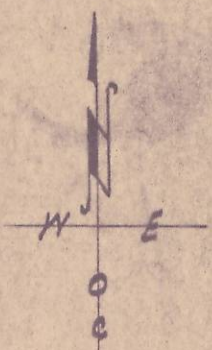


Plat of Part of
Sec. 22, T.4N., R34E., W.M.
Umatilla Co., Ore.
2026' Surveyed, Staked & Platted
Decr. 1949 - By W.E.O. Criger -
Scale: 1 inch = 300 Ft.

Area Const. = 2 06 @ 11
Totals = 464 a = 7 04 A - For Water

J.H. Sampson, et ux.

N.E. Corner of
N.W. 1/4 of S. 1/4 of
Sec. 22, T.4N., R34E., W.M.
Iron Pin - In place.

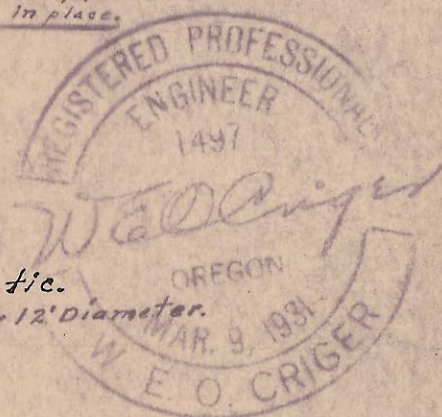

Domestic
Reservoir 12' Diameter.

Y.P. Winans

Y.P. Winans.

I, W.E.O. Criger, of Pendleton, Ore., do hereby
certify that this map was made from notes taken during an actual survey
made by me on Jan. 9th 1953;
that the monument shown on this map consists of a 3/4" iron pipe
30" long - Bearing N. 32°25'W. 858' from E/4 corner on S. Sec. 22 -
Also - N. 68°30'W. 1741' from E/4 Corner of Sec. 22.
Pump Location: as indicated on plat.

W.E.O. Criger.

N. 89°45'W - 79.84 Ch. (on So. Sec. Line)

Y.P. Winans.

North - 80° Chains

5.32°10'W. 855'

1030'

Small
Stream

N. 89°15'W

2 25 a = 464 A.

2 25 a = 464 A.

Jas. H. Sampson - Ph. 23 F. 11.

Athena,

Q-1614-AX

4N 3420