


ELMO E. ROBNETT

Registered Land Surveyor

Box 0176
MILTON, OREGON

E-W. Q. SEC. 25 TWP. 6 N. R. 35 E. W.M.

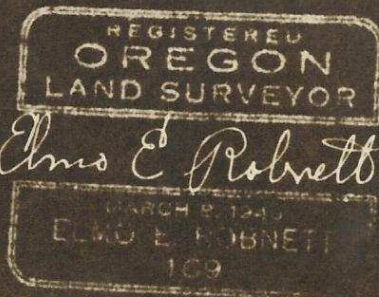

↑ TO WALLA WALLA

OREGON—WASHINGTON SECTION OREGON STATE HIGHWAY

↓ TO MILTON CITY

662.06

150.0

240.40

150.0

240.40

DESCRIPTIVE TRACT.
SECTION 25 TWP. 6 N. R. 35 E. W.M.
SCALE 1"=60' APRIL 1948.

Q-1635-AX

ELMO E. ROBNETT

Registered Land Surveyor

Box 0176
MILTON, OREGON

DESCRIPTIVE TRACT
Section 25 T6N R 35 E

Beginning at the intersection of the East Right of Way line of the Oregon State Highway and the East and West centerline of Section 25 as the same is marked by an iron pin I ran along the said East Right of Way line, 662.06 feet at which point I found an iron pin.

I then ran out the property as shown by the accompanying plat.