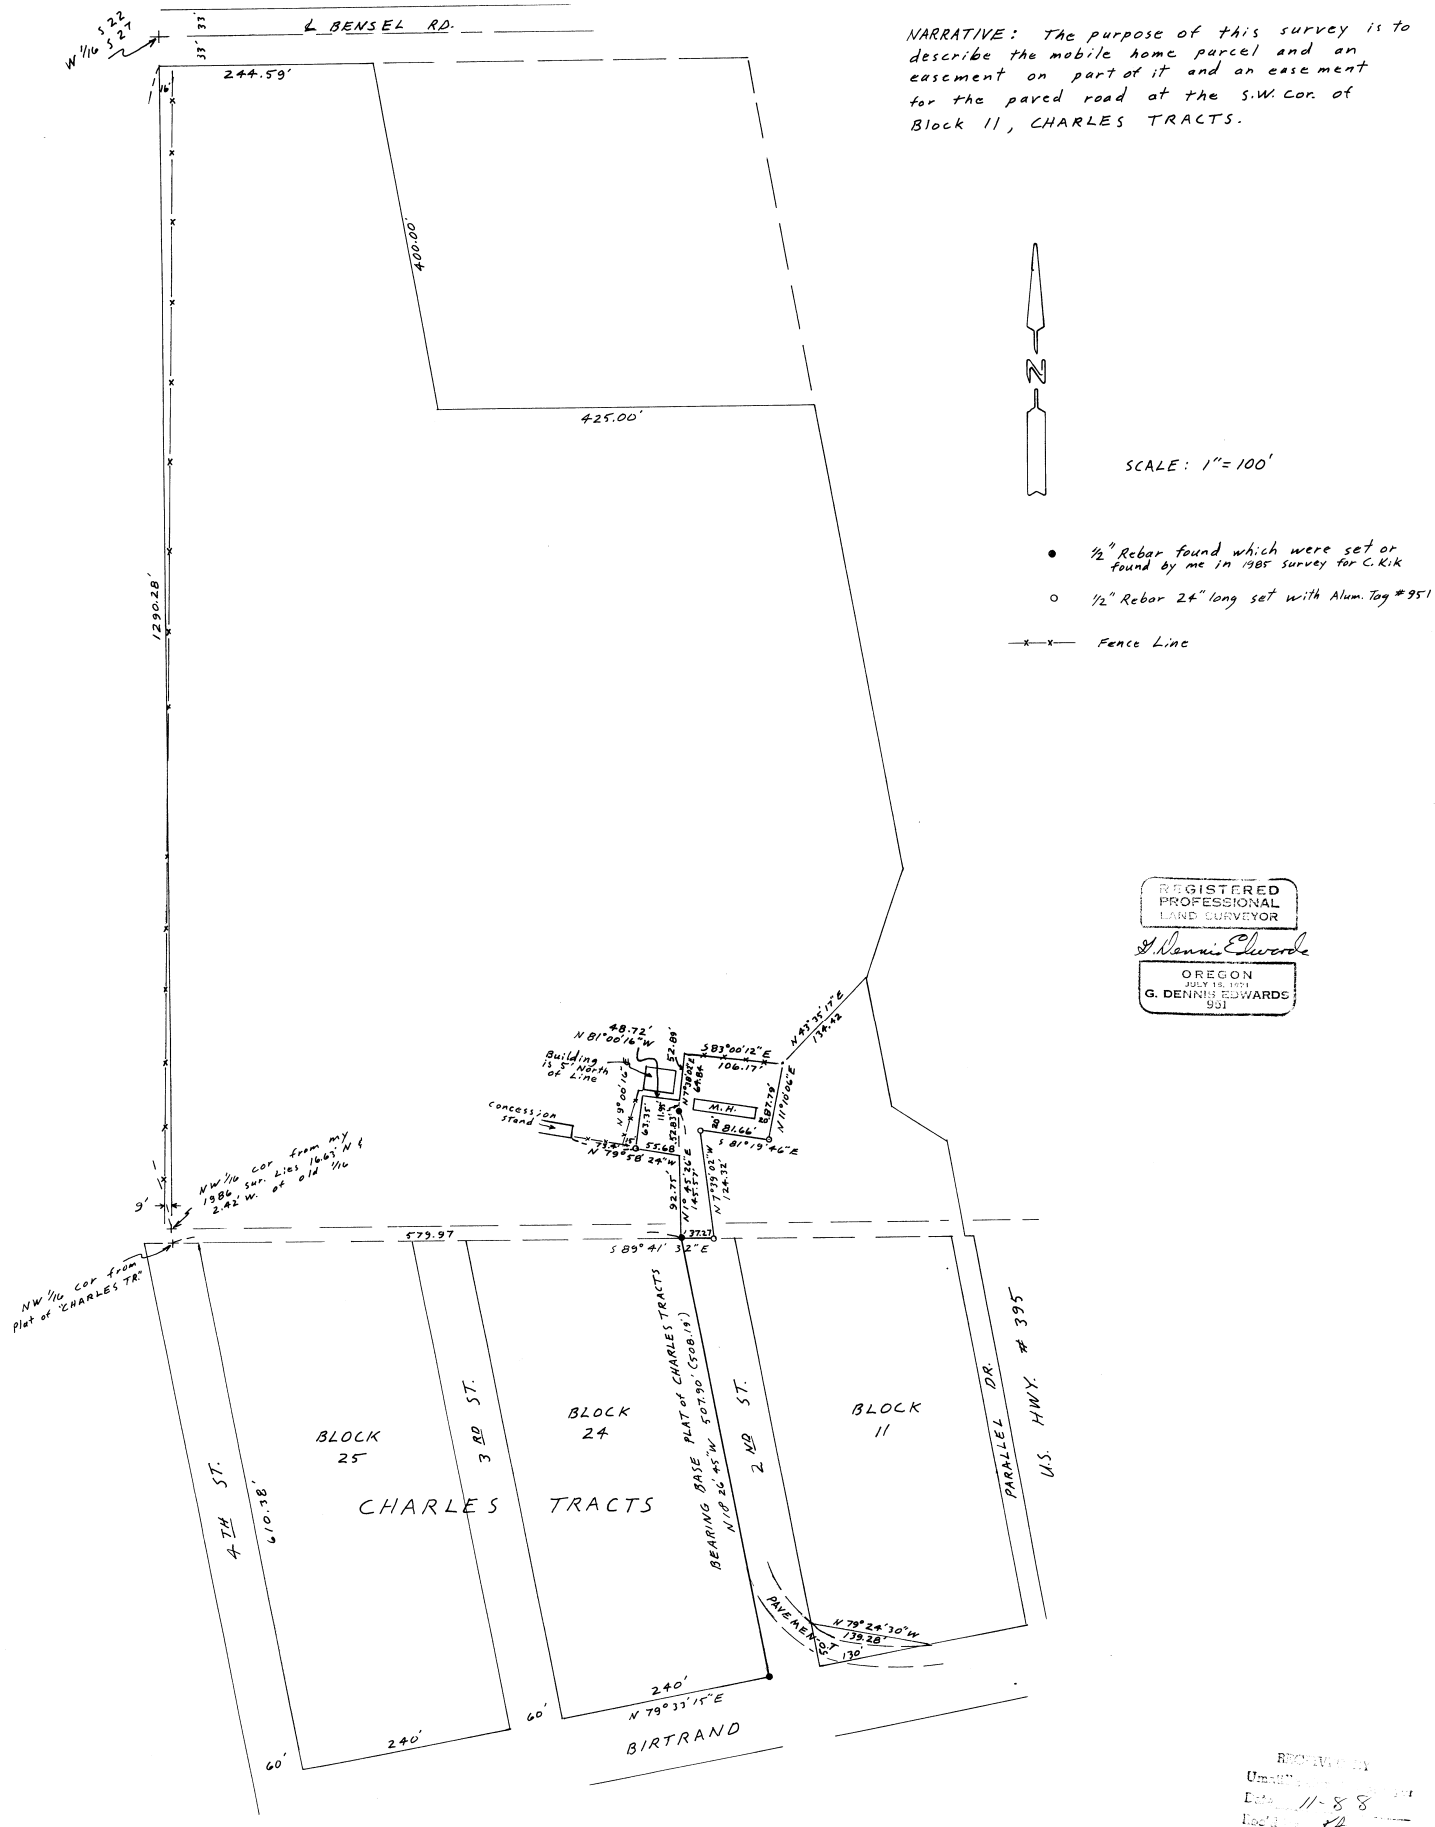

SURVEY FOR CHARLIE KIK
IN NW¼ Sec. 27, T5N, R28E, W.M.
UMATILLA CO. OR.
10/13/88 Job # S 8810033
EDWARDS SURVEYING P.O. Box 763
567-3336 HERMISTON, OR.

Recorded
Umatilla
Date 11-8-88
Book K4
No. 88-71-B