


RECORD OF SURVEY SURVEY
for:
Cascade Natural Gas Corporation
Township 4 North, Range 28 East of Willamette Meridian
Section 9, Southeast 1/4 of the Southeast 1/4
City of Hermiston, Umatilla County

NARRATIVE

This survey was completed for the purpose of re-monumenting the corners of the Cascade Natural Gas Corporation property which was originally surveyed and pinned by Lagier in 1984. I found all but two of the original monuments set by Lagier and used the Record of Survey created by Lagier for the locations of the lost monuments. The Basis of Bearing for this Survey was the found center line of West Highland Avenue which is also the South Line of Section 9. I used the record survey distances along the North and South side of the property to re-establish the locations of the monuments to be set along Southwest 11th Street. The one monument noted along the North boundary was disturbed such that I did not use it to calculate the positions of the monuments to be reset.

REFERENCE SURVEY: 84-107-B TELEK ENGINEERING, 1984

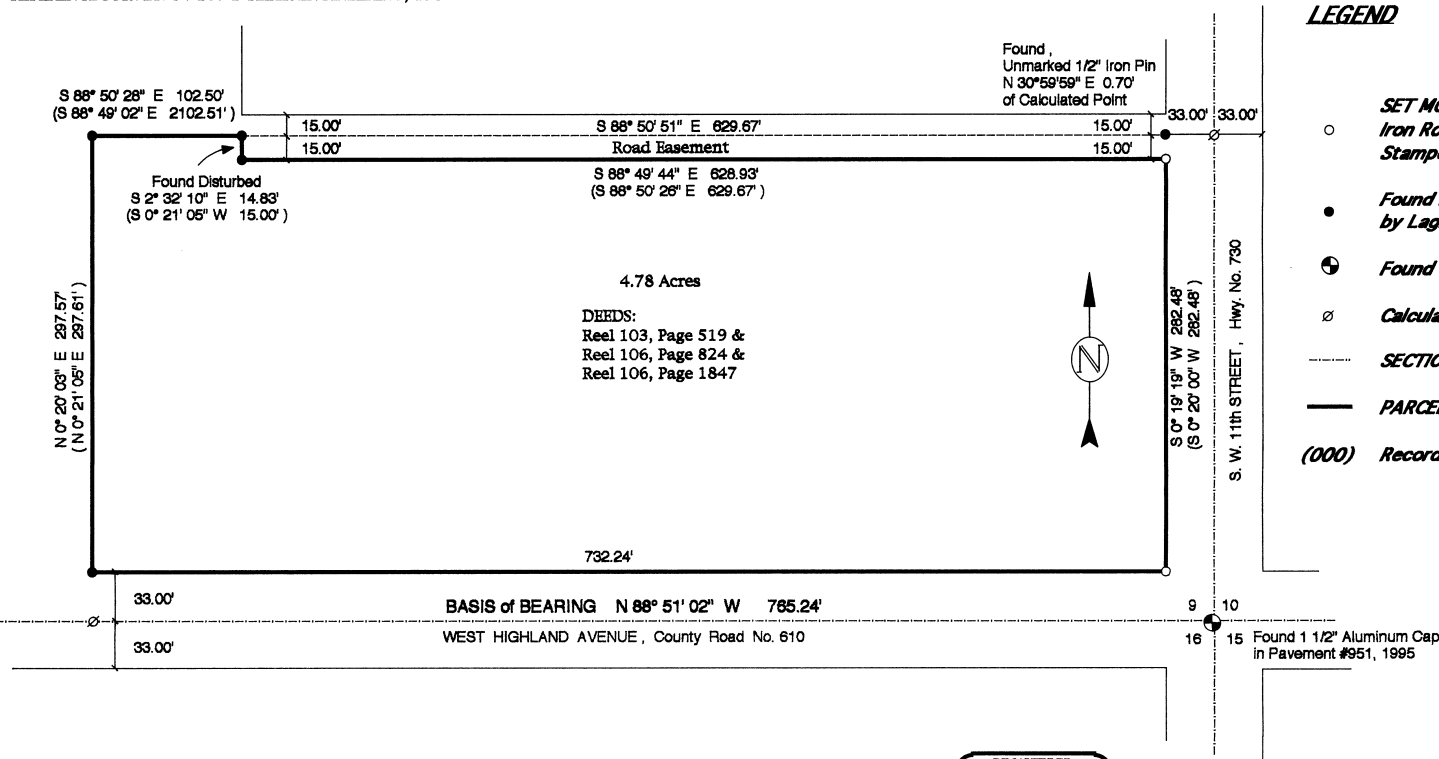

LEGEND

- SET MONUMENTS - 5/8" X 30" Iron Rods W/ Plastic Caps Stamped - L.S. #2431
- Found Monuments- As Set by Lagier in C. S. # 84-107-B
- ⊕ Found Section Monuments - As Noted
- ⊙ Calculated Points - Not Set
- SECTION LINE
- PARCEL BOUNDARY
- (000) Record Distances

REVISIONS BY
 8-96
 KK
 96-134-B

REGISTERED
 PROFESSIONAL
 LAND SURVEYOR
 OREGON
 RONALD V. MCKINNIS
 JAN. 23, 1990
 2431
 Expires 12-31-96

August, 1996
 SCALE 1" = 60 Ft.
 ENGINEERING - SURVEYING - WATER RIGHTS
R V MCKINNIS ENGINEERING
 Rt 1 Box 1122 Hermiston, Oregon 97838
 503-567-2017