


**NARRATIVE:**

The purpose of this survey is to stake the SE 1/4 of the SW 1/4 of the NW 1/4 of Section 21 in preparation for a Partition Plat. I surveyed this parcel in a 1976 survey for Ward but the SW corner of the section was determined to be in error and in 1979 Cramer set a new one 23.6 feet West of Thompson's. In my 1991-2 County Remonumentation Survey I set corners North of the NW corner and the West 1/4 corner of this Section which fit improvements better than the previous monuments. But while conducting this survey I have determined that the pre-1991 GLO corners fit the improvements in this Section better than my new ones so I used the pre-1991 corners for this survey. The 1991 monuments will probably fit the improvements better in Sections 16, 17 and 20.

REGISTERED PROFESSIONAL LAND SURVEYOR  
*G. Dennis Edwards*  
 OREGON  
 JULY 16, 1971  
 G. DENNIS EDWARDS  
 831  
 RENEWS 12/31/97

**LEGEND:**

- Found monuments, as noted.
- Set 5/8" x 30" rebar with plastic cap #951.

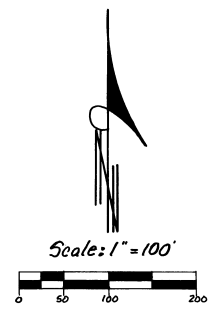

RECEIVED BY  
 Umatilla County Surveyor  
 Date: 10-96  
 Initials: KE  
 No. 96-169-B

Survey for STEVE & TERRI VOORHEES (PEREZ)  
 in NW 1/4 Section 21, T44N, R28E, W.1.M.,  
 Umatilla County, Oregon  
 10/16/96 Job #59610206-A  
 Edwards Surveying P.O. Box 763  
 541-567-3336 Hermiston, Oregon 97836