


N 2. 7 0 5 - 0

ONE-QUARTER CORNER
FOUND W.C. & SPIKE

CENTER SEC. 10
FOUND R.R. SPIKE

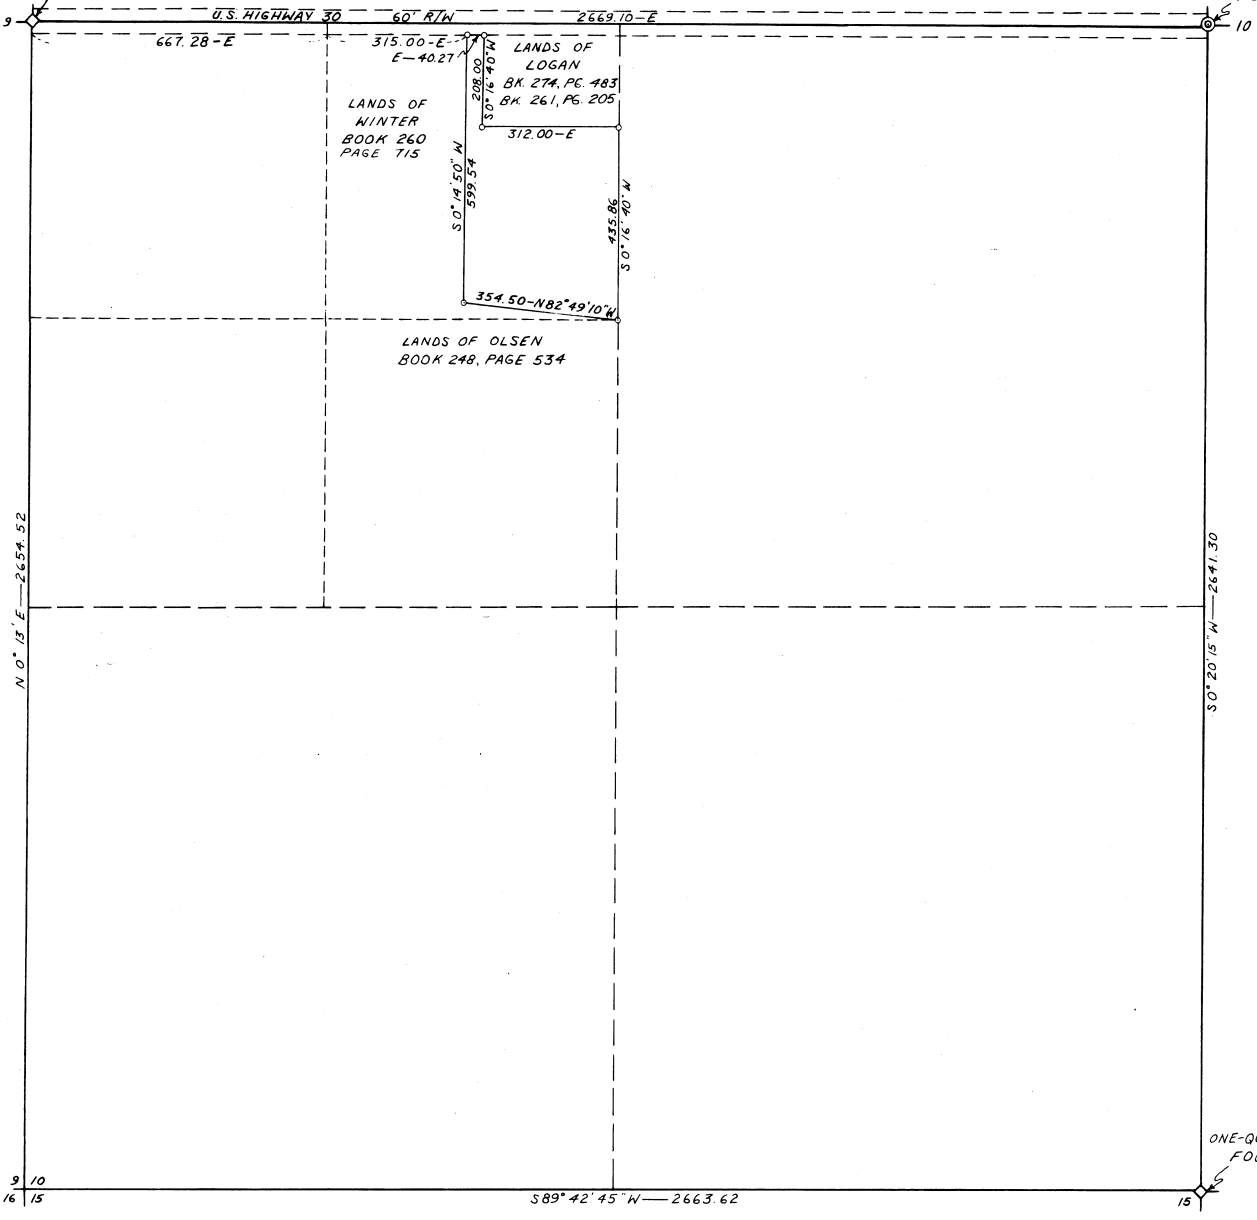

○ DENOTES 5/8" IRON PIN SET

REGISTERED
CHIEF
LAND SURVEYOR

Leland H. Flaschen

LELAND FLASCHEN
SIN

W.O. HARRIS & ASSOCIATES

SURVEY FOR
ROBERT O'Rourke
PARCEL IN SW 1/4, SEC. 10
T. 2 N., R. 33 E., W. M.

SCALE	DATE	DRN. BY	DRWG. NO.
1" = 200'	8-1-66	EKO	66-196-C