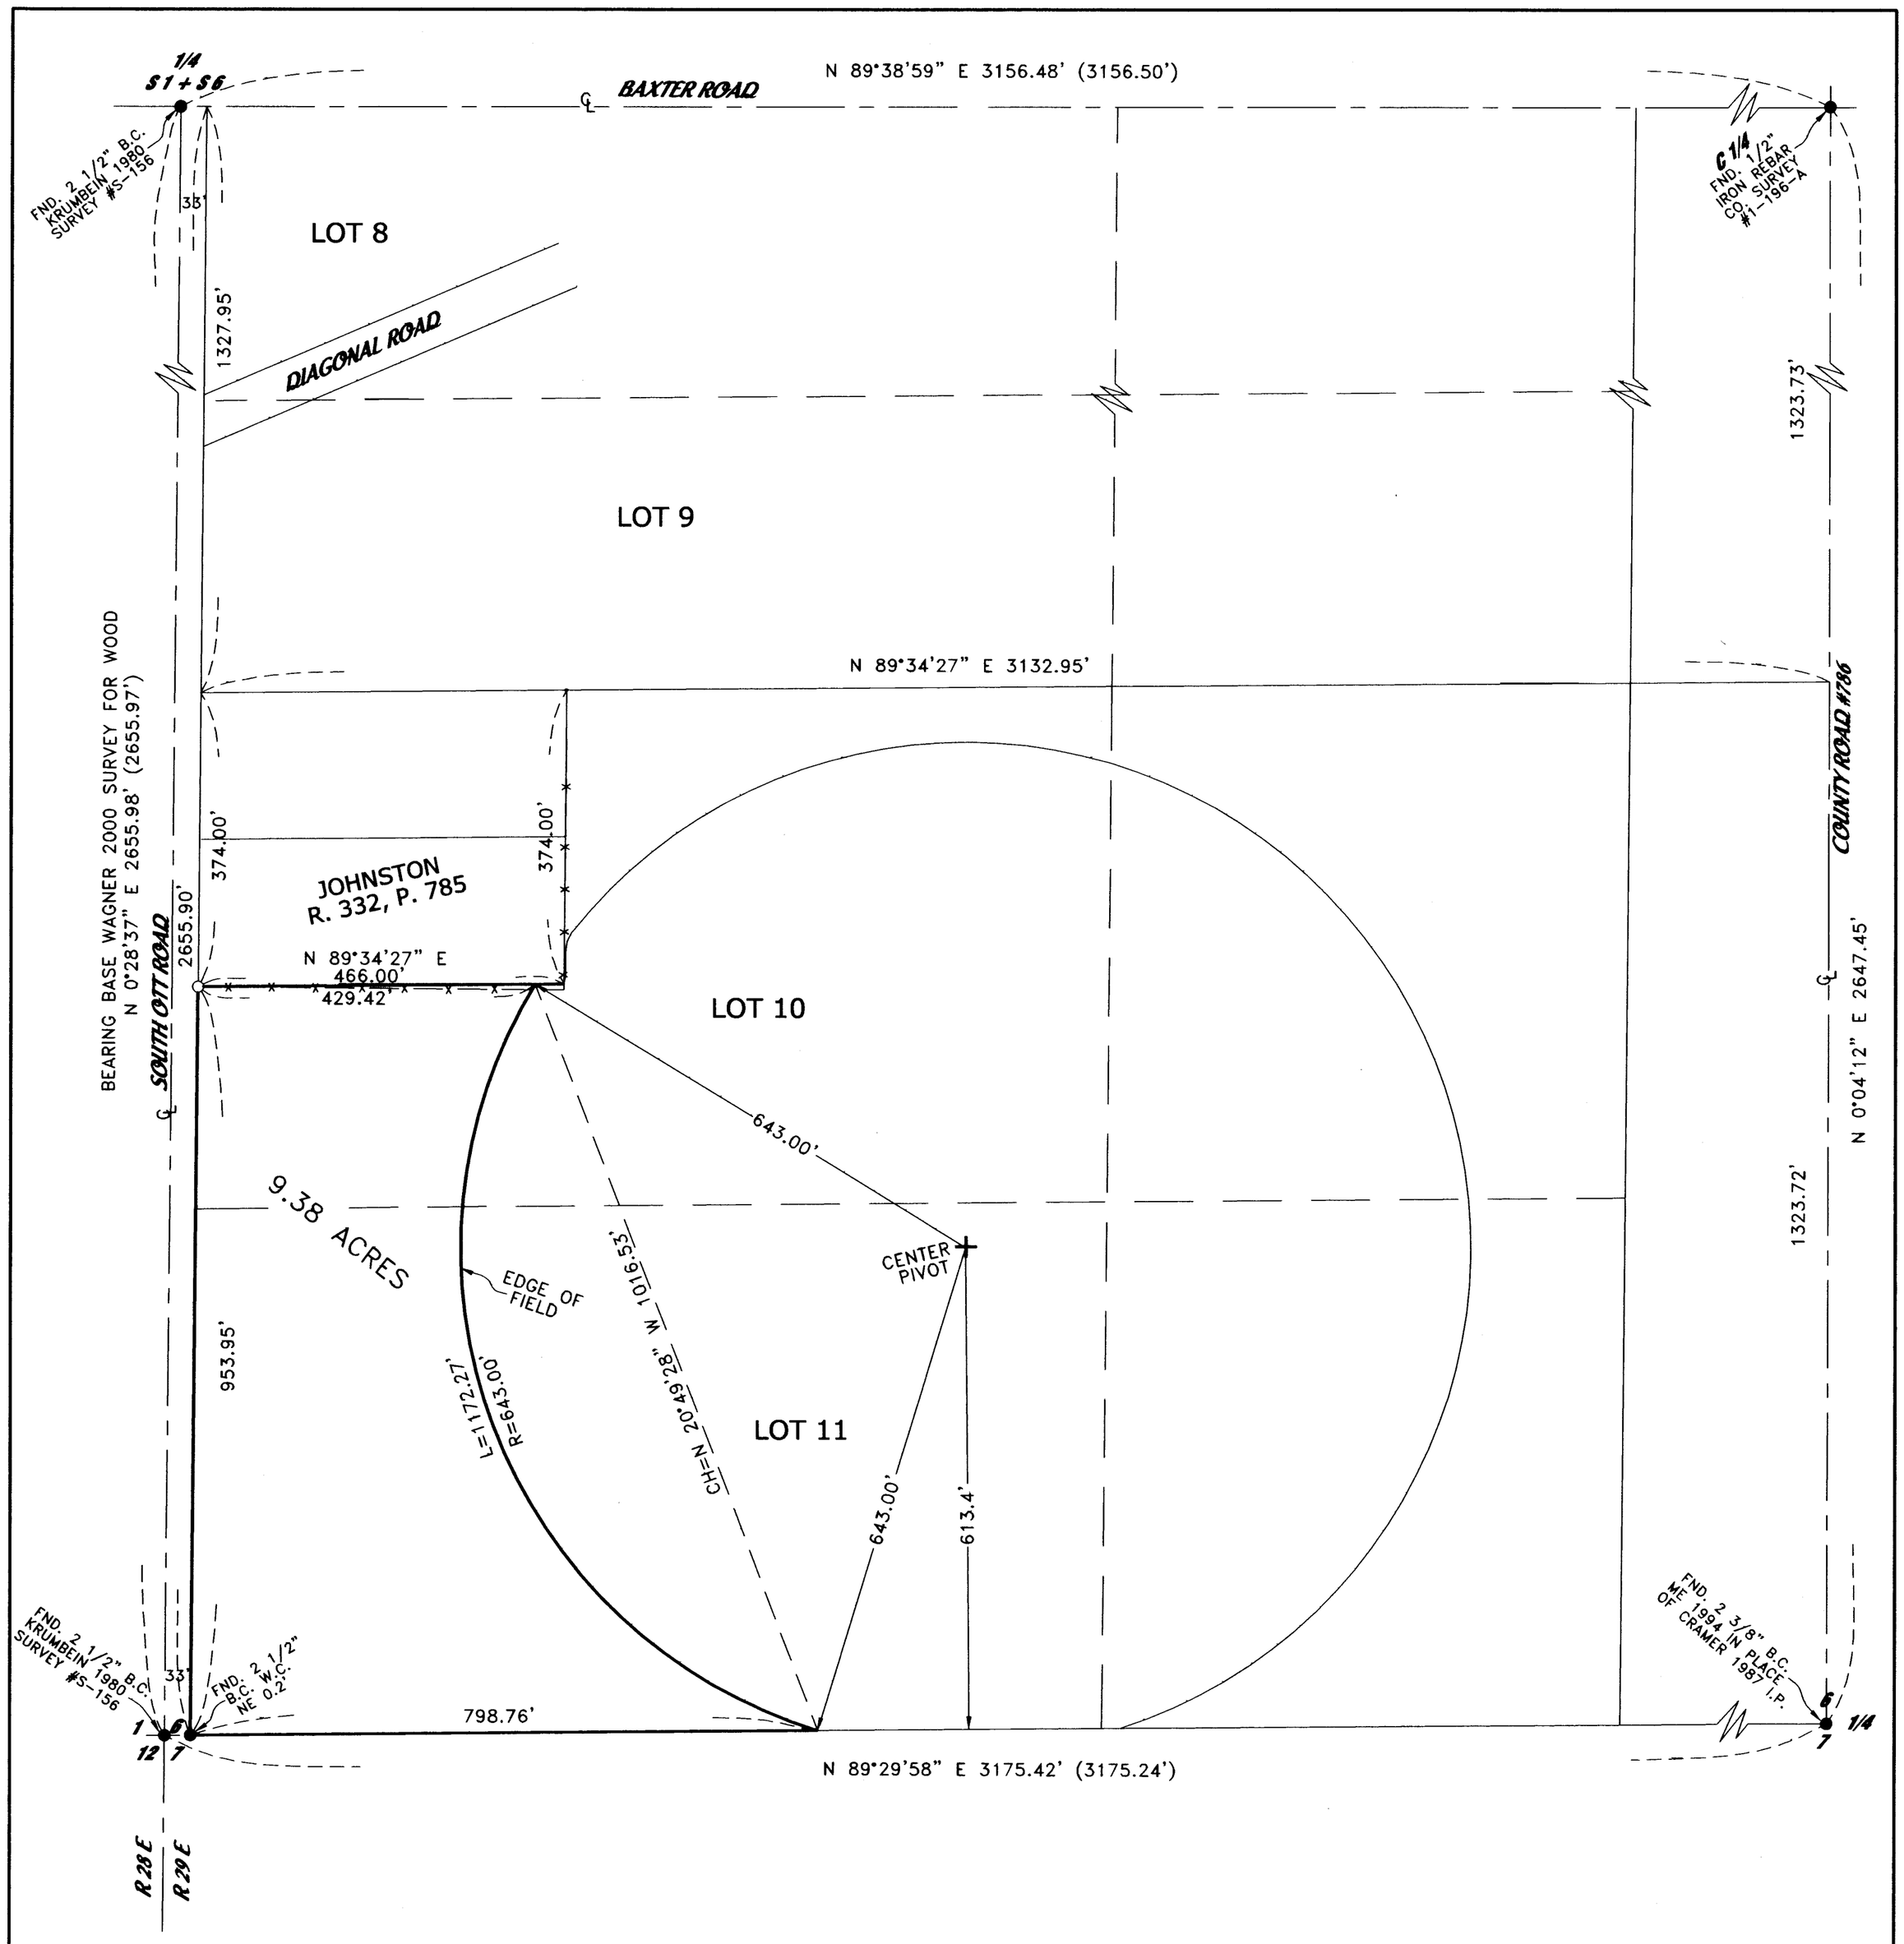

NARRATIVE:

THE PURPOSE OF THIS SURVEY IS TO SEE HOW MUCH UNIRRIGATED LAND LIES BETWEEN OTT ROAD AND A CENTER PIVOT FIELD LYING WITHIN THAT TRACT OF LAND DEEDED TO KENNETH PETERSON ON REEL 441, PAGE 33, UMATILLA COUNTY DEED RECORDS.

I BASED THE BEARINGS OF THIS SURVEY ON ONE DONE BY WAGNER IN 2000 FOR WOOD.

REGISTERED
PROFESSIONAL
LAND SURVEYOR

G. Dennis Edwards

OREGON
JULY 16, 1971
G. DENNIS EDWARDS
9 5 1
RENEWS 12/31/2005

N

Scale 1"=150Feet

0 50 200
25 100

RECEIVED BY
Umatilla County Surveyor
Date 5-04
Rec'd By KC
No. 04-104-B

LEGEND:

● FOUND MONUMENTS AS NOTED
○ SET 5/8"X30" IRON REBAR WITH PLASTIC CAP #951
[000] OF RECORD, WAGNER 2000 SURVEY

SURVEY FOR DR. KEN PETERSON
IN SW 1/4, SEC. 6, T 4 N, R 29 E, W.M.,
UMATILLA COUNTY, OREGON
4/14/2004 JOB# S0403056
EDWARDS SURVEYING P.O. BOX 763
541-567-3336 HERMISTON, OREGON 97838
DRAWN BY NJF