
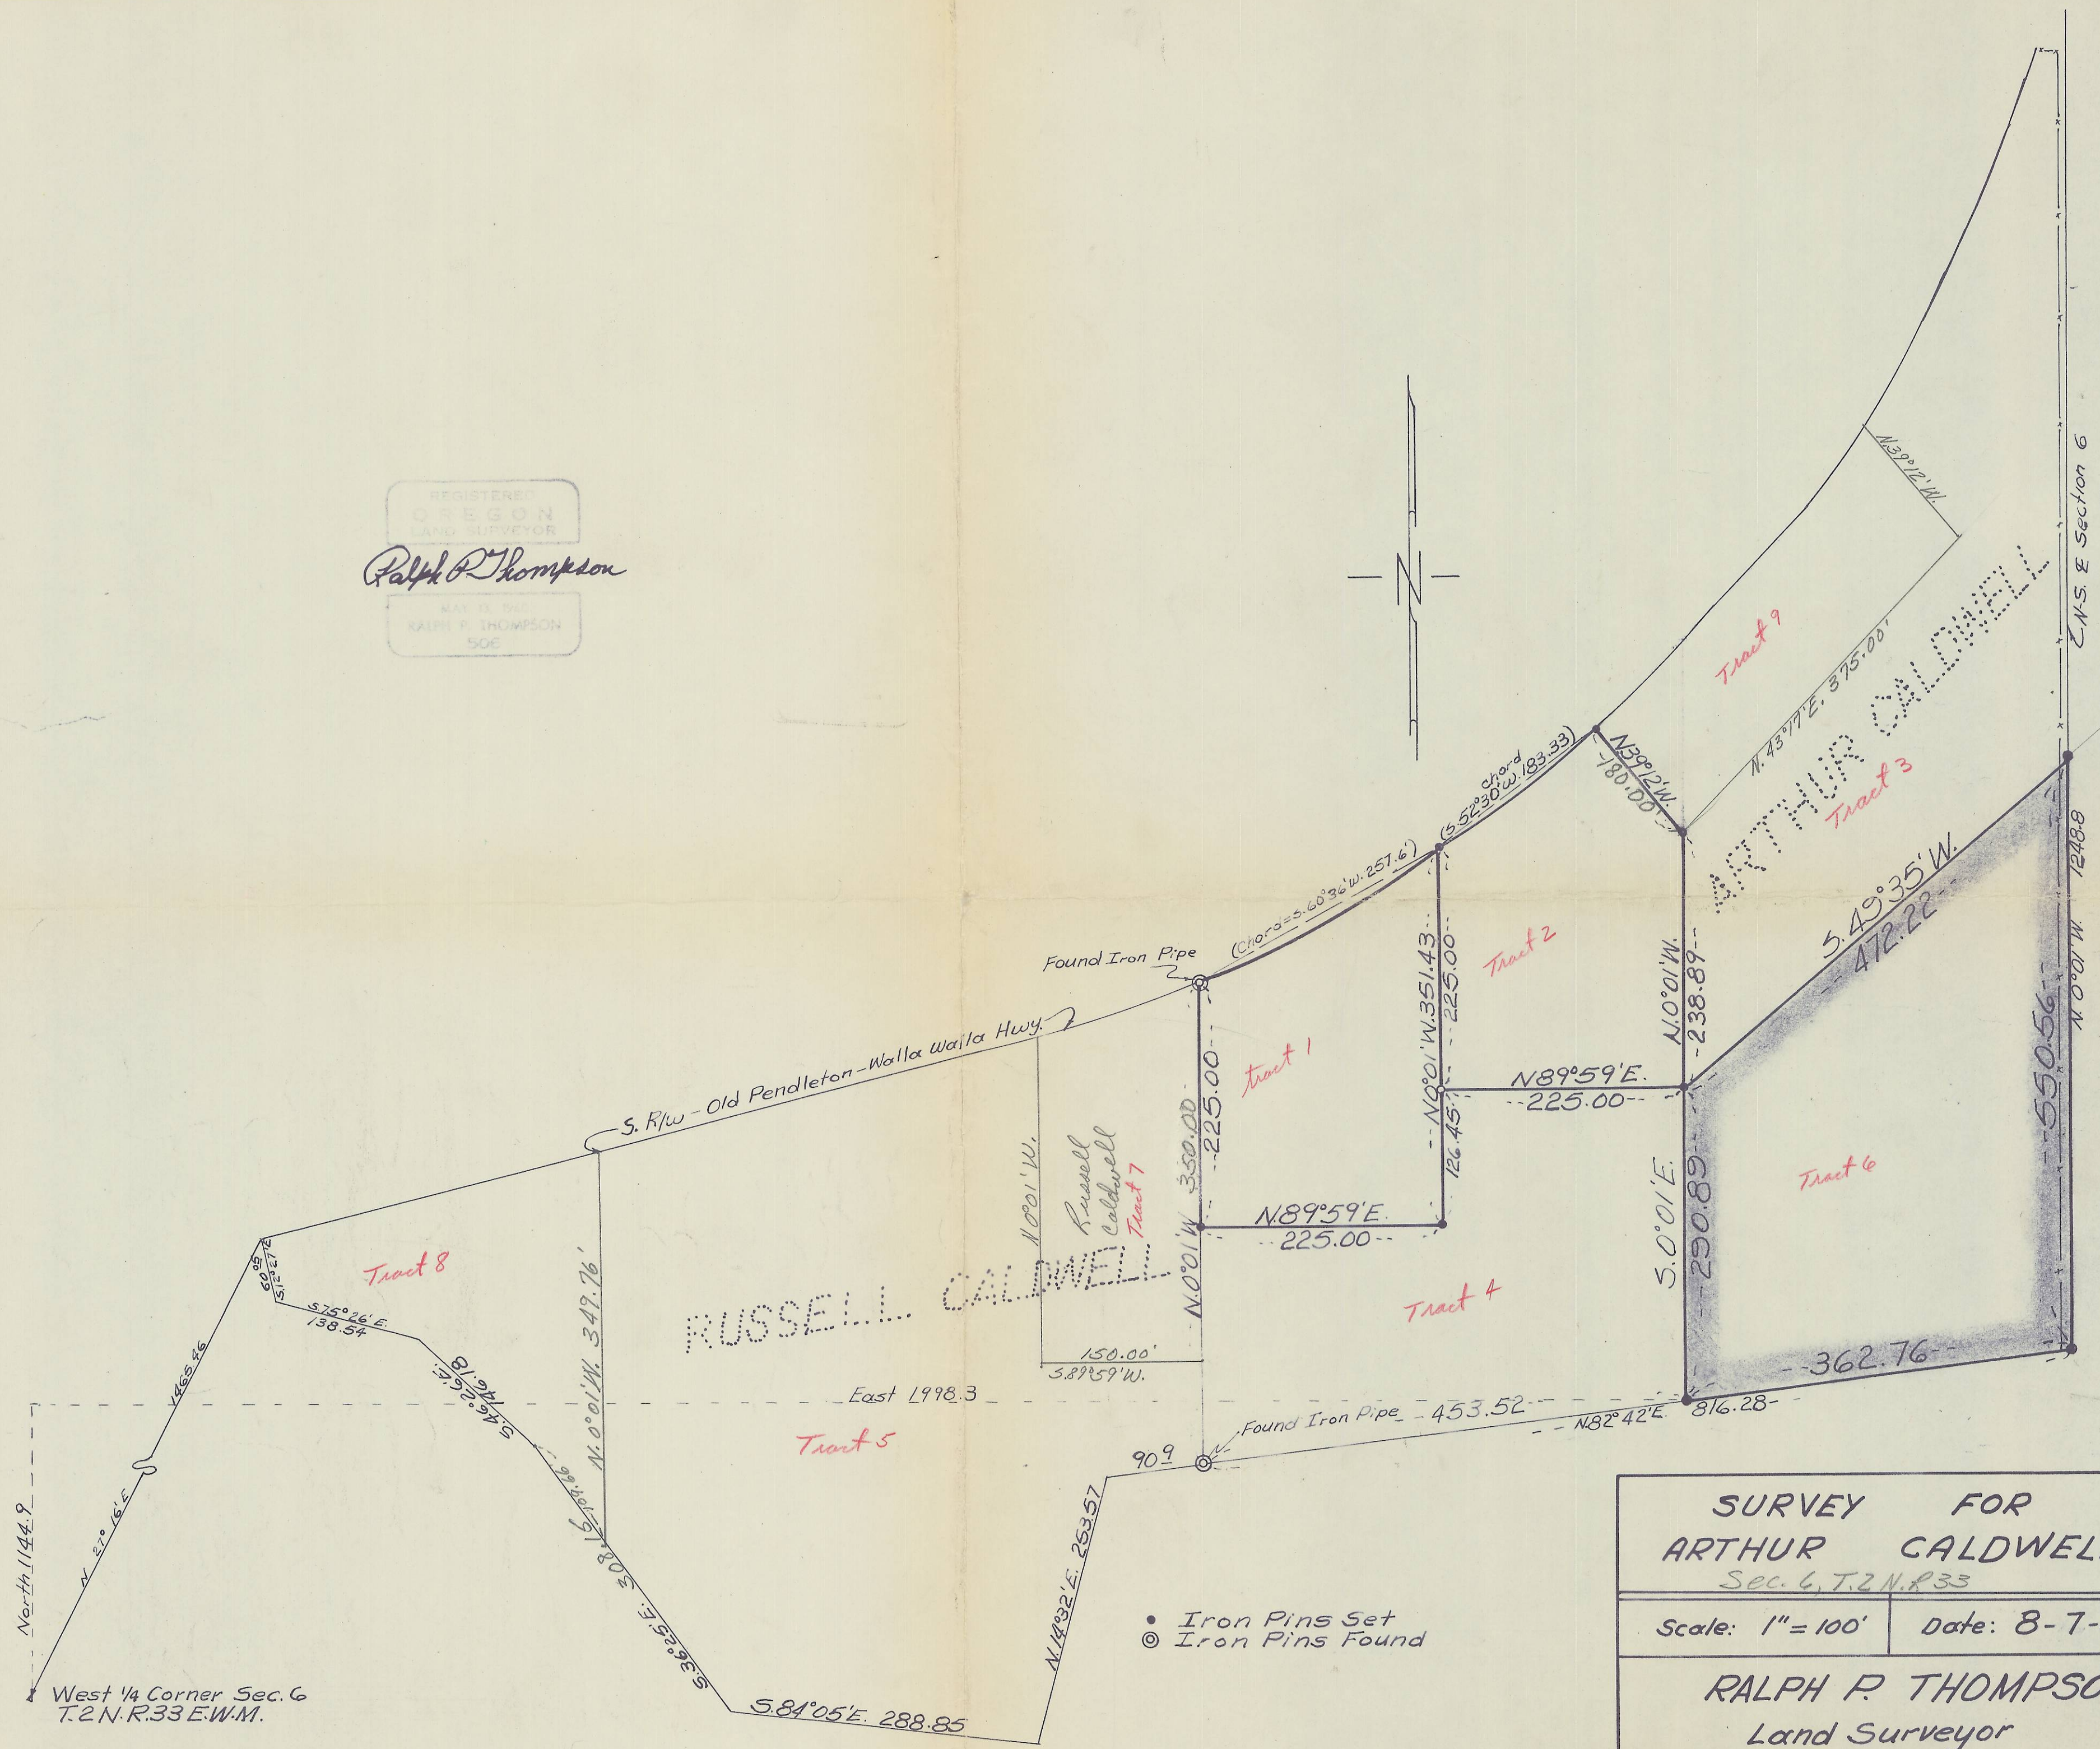


REGISTERED
OREGON
LAND SURVEYOR
Ralph P. Thompson
MAY 12 1960
RALPH P. THOMPSON
506

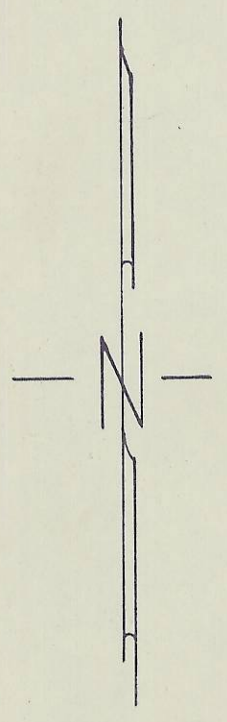

North 1144.9
West 1/4 Corner Sec. 6
T.2 N. R. 33 E. W. M.

• Iron Pins Set
⊙ Iron Pins Found

SURVEY FOR ARTHUR CALDWELL Sec. 6, T.2 N. R. 33	
Scale: 1" = 100'	Date: 8-7-61
RALPH P. THOMPSON Land Surveyor Pendleton Oregon	

07-155-18