NOTE: THIS SURVEY IS BASED ON ORIGINAL MONUMENTS FOUND IN THE FIELD. MEASURED ANGLES AND DISTANCES DO NOT CORRESPOND WITH ANGLES AND DISTANCES GIVEN ON THE RECORDED PLAT OF LOBAUGH AND STORER ADDITION TO HERMISTON, OREGON. MEASURED DISTANCES AND ANGLES DO HOWEVER, CORRESPOND TO OTHER SURVEYS OF RECORD. LOT DIMENSIONS ARE THE RESULT OF PROPORTIONING OF THE DISTANCES MEASURED BETWEEN THE MONUMENTS FOUND.

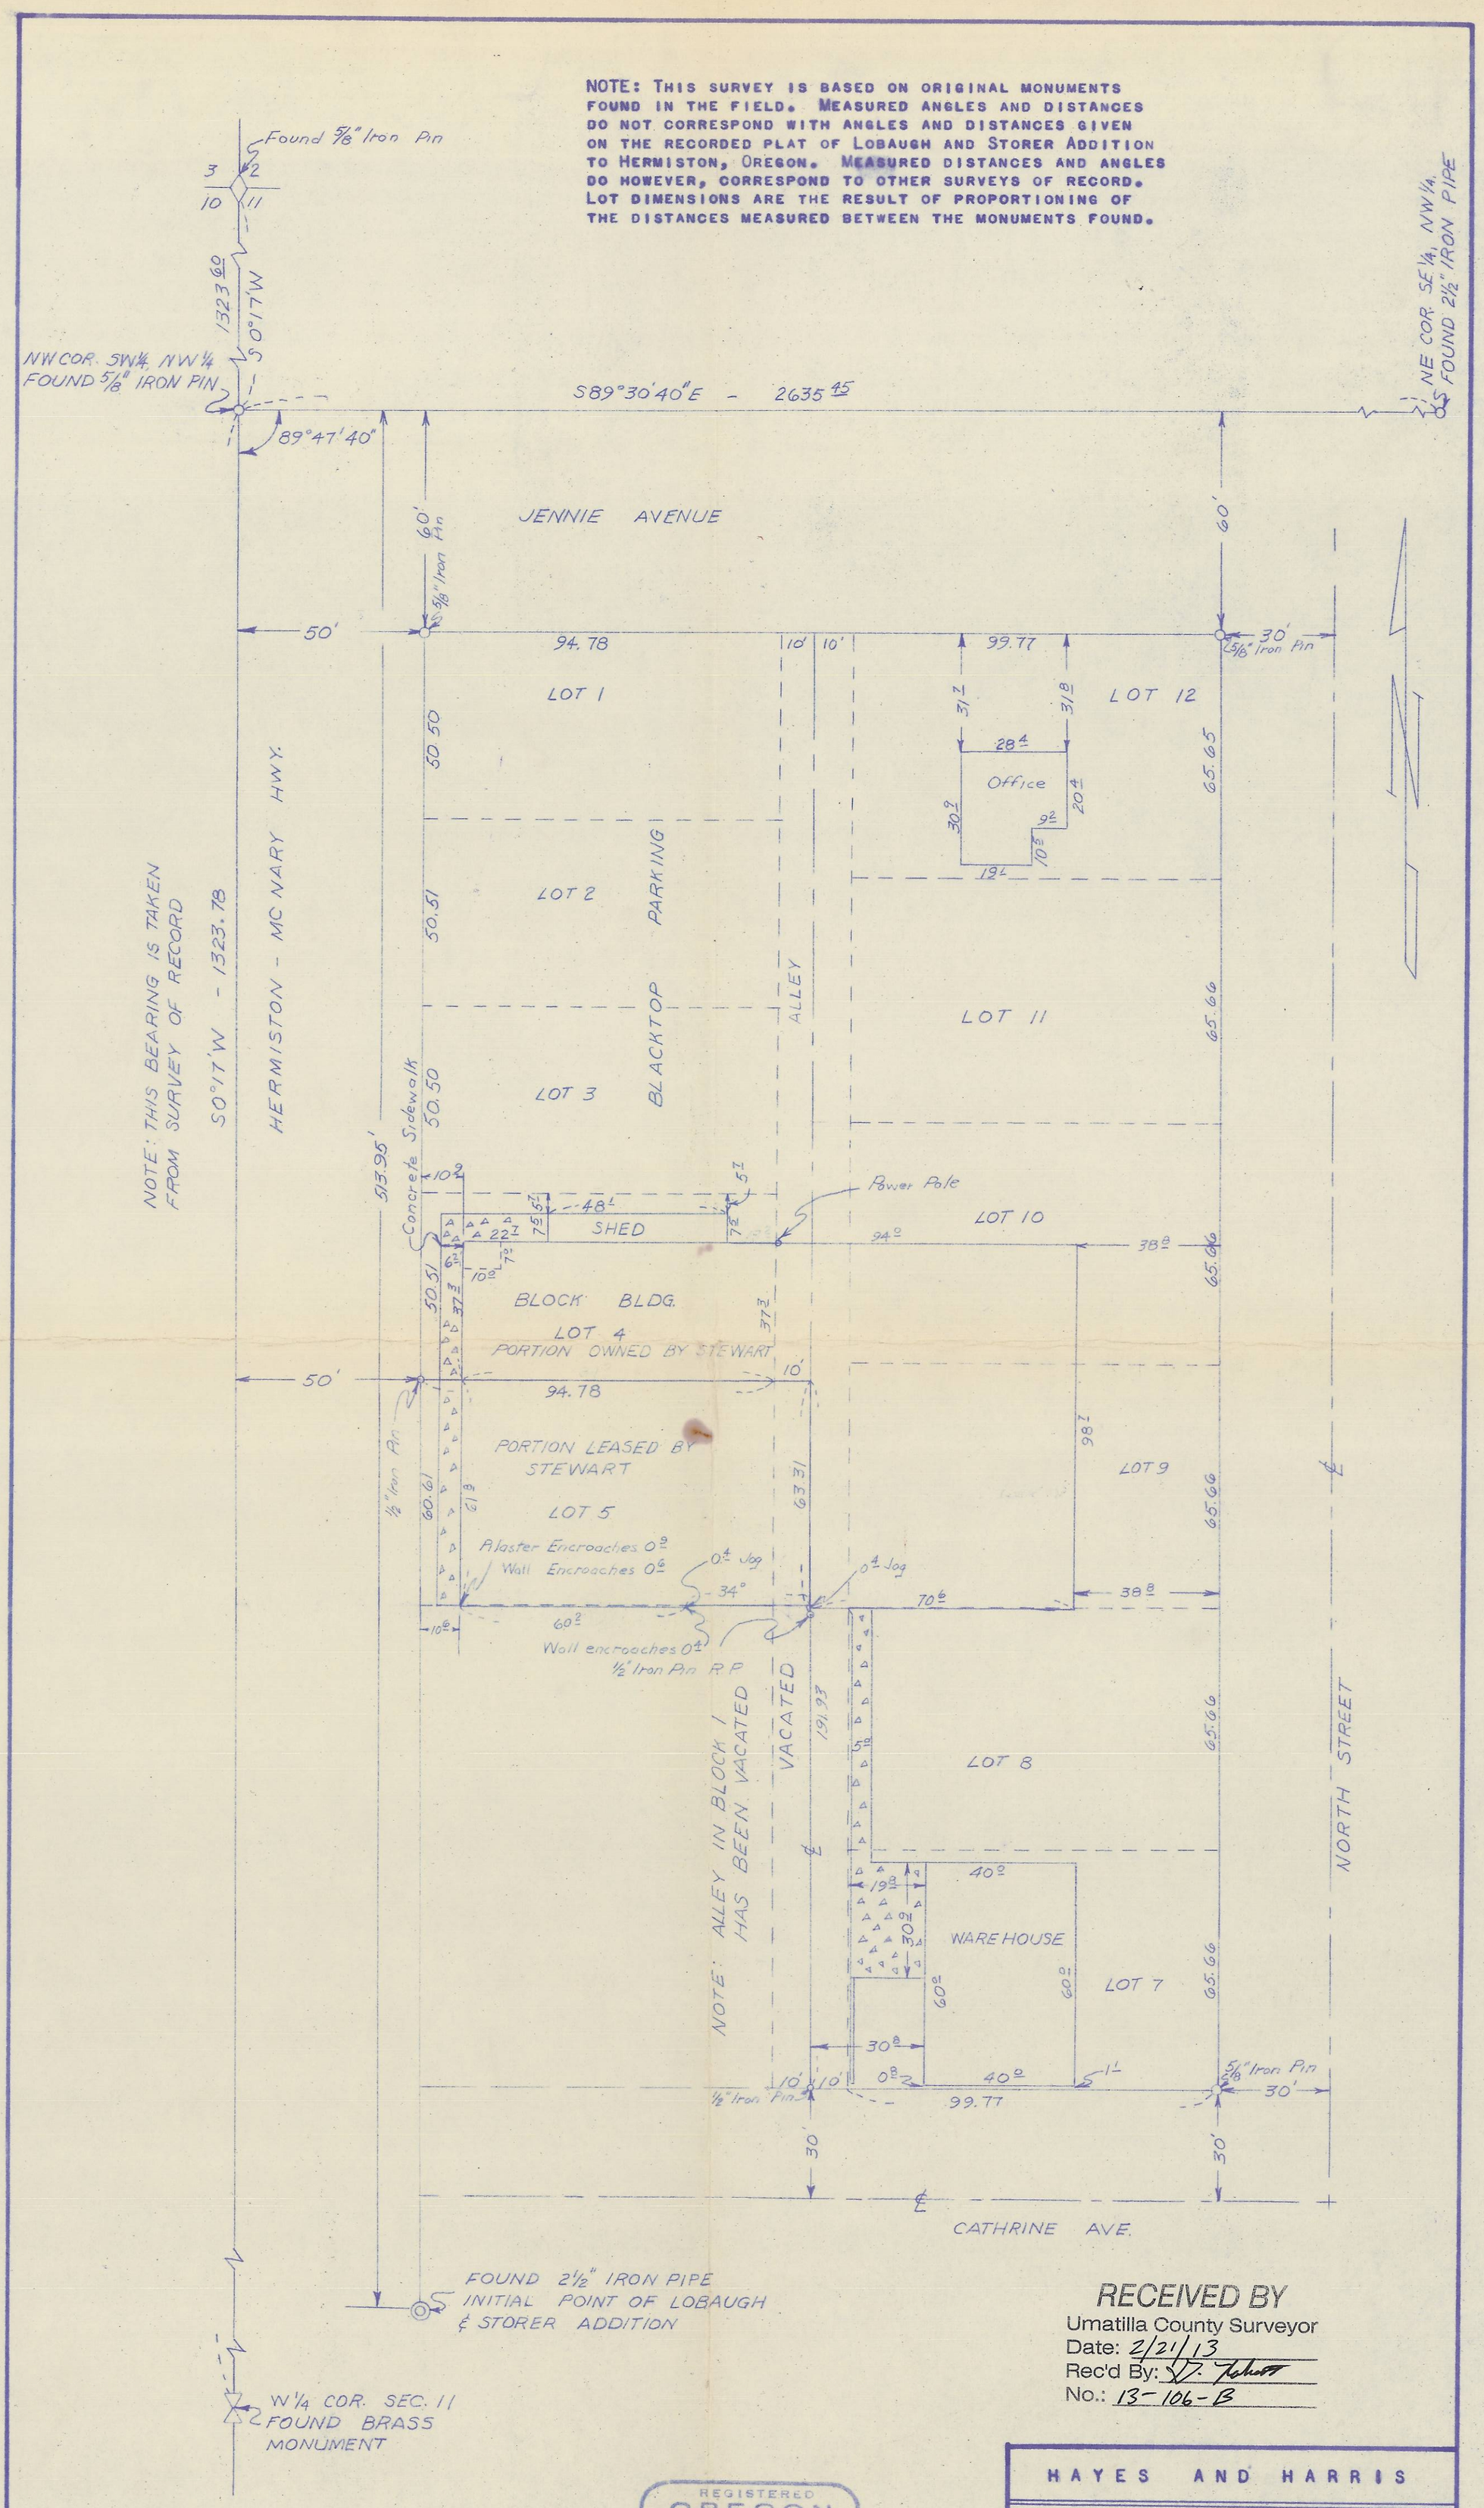

RECEIVED BY
Umatilla County Surveyor
Date: 2/21/13
Rec'd By: D. Talbott
No.: 13-106-B

REGISTERED
OREGON
LAND SURVEYOR
Wayne O. Harris
MAY 6, 1955
WAYNE O. HARRIS
346

HAYES AND HARRIS

PLOT PLAN

LOTS 1,2,3,4,7,8,9,10,11,12 BLOCK 1
PORTION OF VACATED ALLEY

LOBAUGH AND STORER ADDITION
HERMISTON, OREGON

SCALE	DATE	DRN. BY.	DRNG. NO.
1"=30'	7-25-62	L.H.A.	62-137-C

4N 28 11 BC