

NARRATIVE:


THE PURPOSE OF THIS SURVEY IS TO STAKE THE CORNERS OF LOT 5, BLOCK 6, "WESTLAND ESTATES" FOR A PENDING SALE.
 I SURVEYED LOT 10 IN A 1997 SURVEY FOR CENTURY 21 REALTY BUT COULD NOT FIND THE MONUMENTS AT THE SOUTH CORNERS. I FOUND THE NORTH CORNERS OF SAID LOT 10 BUT THE NW CORNER WAS DISTURBED AND LEANING NW AND THE NE CORNER HAD BEEN MOVED OVER 3 FEET TO THE SOUTHEAST.
 I USED THE 5 FOUND MONUMENTS, AS SHOWN, TO RETRACE STAEBLER'S 1972 PLAT OF "WESTLAND ESTATES" TO SET THE THREE MISSING CORNERS OF SAID LOT 5.
 I USED A SOKKIA SET 300 TOTAL STATION TO CONDUCT THIS SURVEY.

REGISTERED
 PROFESSIONAL
 LAND SURVEYOR
G. Dennis Edwards
 OREGON
 JULY 16, 1971
 G. DENNIS EDWARDS
 9 5 1
 RENEWS 12/31/2015

LEGEND:

- FOUND 1" IRON BAR SET BY STAEBLER IN 1972 SURVEY OF "WESTLAND ESTATES", UNLESS NOTED OTHERWISE
- SET 5/8"X30" IRON REBAR WITH PLASTIC CAP #951
- ⊗ COMPUTED LOCATION FROM PLAT OF "WESTLAND ESTATES" (000) OF RECORD, STAEBLER, 1972 PLAT OF "WESTLAND ESTATES"

RECEIVED BY
 Umatilla County Surveyor
 Date: 4/16/2014
 Paid By: G. Hensley
 No: 14-126-B

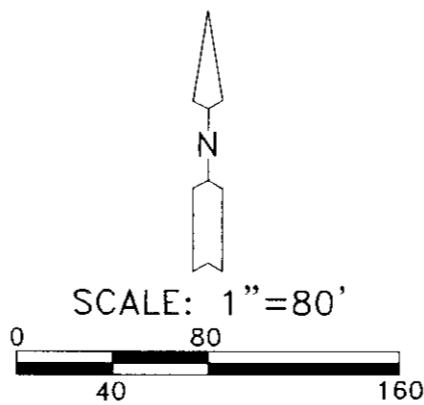

SURVEY FOR STEVE GASS
 IN BLK 6, "WESTLAND ESTATE" SW 1/4 NW 1/4,
 & NW 1/4 SW 1/4, SEC. 17, T 4 N, R 28 E,
 W.M., UMATILLA COUNTY, OREGON
 05/27/2014 JOB# S1405024
 EDWARDS SURVEYING P.O. BOX 763
 541-567-3336 HERMISTON, OREGON 97838
 DRAWN BY JMC