



LINE	BEARING	DISTANCE
A	S 00° 10' 18" W	33.00
B	S 69° 43' 58" W	312.43
C	S 54° 03' 35" W	425.09
D	S 79° 59' 02" W	124.51
E	N 82° 21' 26" W	139.33
F	N 87° 19' 23" W	136.35
G	S 08° 48' 45" E	449.67
H	S 28° 18' 43" E	463.98
I	S 82° 23' 21" W	198.83
J	N 73° 30' 56" W	156.28
K	N 36° 33' 59" W	200.68
L	N 81° 40' 19" W	213.35
M	N 28° 13' 18" W	305.74
N	N 39° 55' 22" W	331.00
O	N 67° 51' 23" W	383.42
P	N 88° 24' 47" W	571.30
Q	S 60° 49' 22" W	294.16
R	S 09° 40' 39" W	581.60
S	S 19° 41' 20" W	607.65
T	S 50° 05' 47" W	161.49
U	N 85° 40' 28" W	238.01
V	N 76° 26' 51" W	206.00
W	N 44° 50' 11" W	355.60
X	N 78° 04' 17" W	232.15
Y	S 77° 15' 47" W	383.80
Z	S 41° 30' 52" W	992.85
A'	N 01° 14' 28" E	2182.00
B'	N 89° 54' 00" E	5280.00

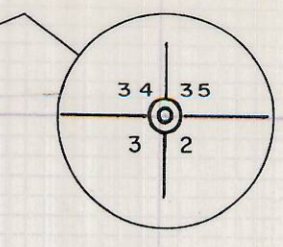

Found STONE w / 4 notches
7" x 10" x 18"

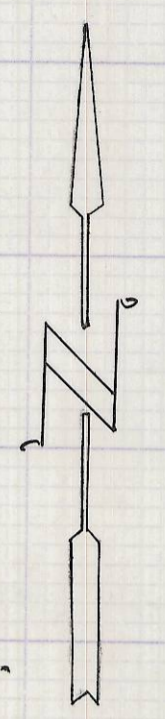

S O L A R O B S E R V A T I O N	
	<p>Date April 7, 1967</p> <p>Standard Time 2^h 44^m 38^s P.M.</p> <p>Declination N 6° 50' 22.8"</p> <p>Ref. & Parallax - 0° 01' 18"</p> <p>Latitude N 45° 48' 35"</p> <p>Horizontal Angle 55° 17' 13.8"</p> <p>Vertical Angle 37° 14' 58.4"</p>

LEGEND

- ⊙ Monument Found
- Set 1/2" x 24" I.P.

Bearings and distances shown in "()" are from G.L.O. Notes.

REGISTERED
OREGON
LAND SURVEYOR

Ralph P. Thompson

MAY 13, 1960
RALPH P. THOMPSON
506

SURVEY FOR
W. E. Du PUIS

SECTION 3, TWSR. 2 N., RANGE 30 E.W.M.

Date: April 14, 1967 Scale: 1" = 40'

RALPH THOMPSON
REGISTERED LAND SURVEYOR
P. O. BOX 1082 PENDLETON, ORE. 97801

D-13
B

LEGAL DESCRIPTION

Beginning at the N.E. Corner of Section 3, T 2N., Range 30 E.W.M. and the True Point of Beginning of this description.

. . . ; Thence S. 00°10'18"W. along the East line of said Section 3 a distance of 33.00 feet; Thence S. 69°43'58"W. a distance of 312.43 feet; Thence S. 54°03'35"W. a distance of 425.09 feet; Thence S. 79°59'02"W. a distance of 124.51 feet; Thence N. 82°21'26"W. a distance of 139.33 feet; Thence N. 87°19'23"W. a distance of 136.35 feet; Thence S. 08°48'45"E. a distance of 449.67 feet; Thence S. 28°18'43"E. a distance of 463.98 feet; Thence S. 82°23'21"W. a distance of 198.83 feet; Thence N. 73°30'56"W. a distance of 156.28 feet; Thence N. 36°33'59"W. a distance of 200.68 feet; Thence N. 81°40'19"W. a distance of 213.35 feet; Thence N. 28°13'18"W. a distance of 305.74 feet; Thence N. 39°55'22"W. a distance of 331.00 feet; Thence N. 67°51'23"W. a distance of 383.42 feet; Thence N. 88°24'47"W. a distance of 571.30 feet; Thence S. 60°49'22"W. a distance of 294.16 feet; Thence S. 09°40'39"W. a distance of 581.60 feet; Thence S. 19°41'20"W. a distance of 607.65 feet; Thence S. 50°05'47"W. a distance of 161.49 feet; Thence N. 85°40'28"W. a distance of 238.01 feet; Thence N. 76°26'51"W. a distance of 206.00 feet; Thence N. 44°50'11"W. a distance of 355.60 feet; Thence N. 78°04'17"W. a distance of 232.15 feet; Thence S. 77°15'47"W. a distance of 383.80 feet; Thence S. 41°30'52"W. a distance of 992.85 feet; more or less to a point on the West line of said Section 3; Thence N. 01°14'28"E. along said West line a distance of 2182.00 feet more or less to the Northwest Section corner of said Section 3; Thence N. 89°54'00"E. along the North line of said Section 3 a distance of 5280 feet more or less to the point of beginning.

Containing 117.5 Acres more or less.