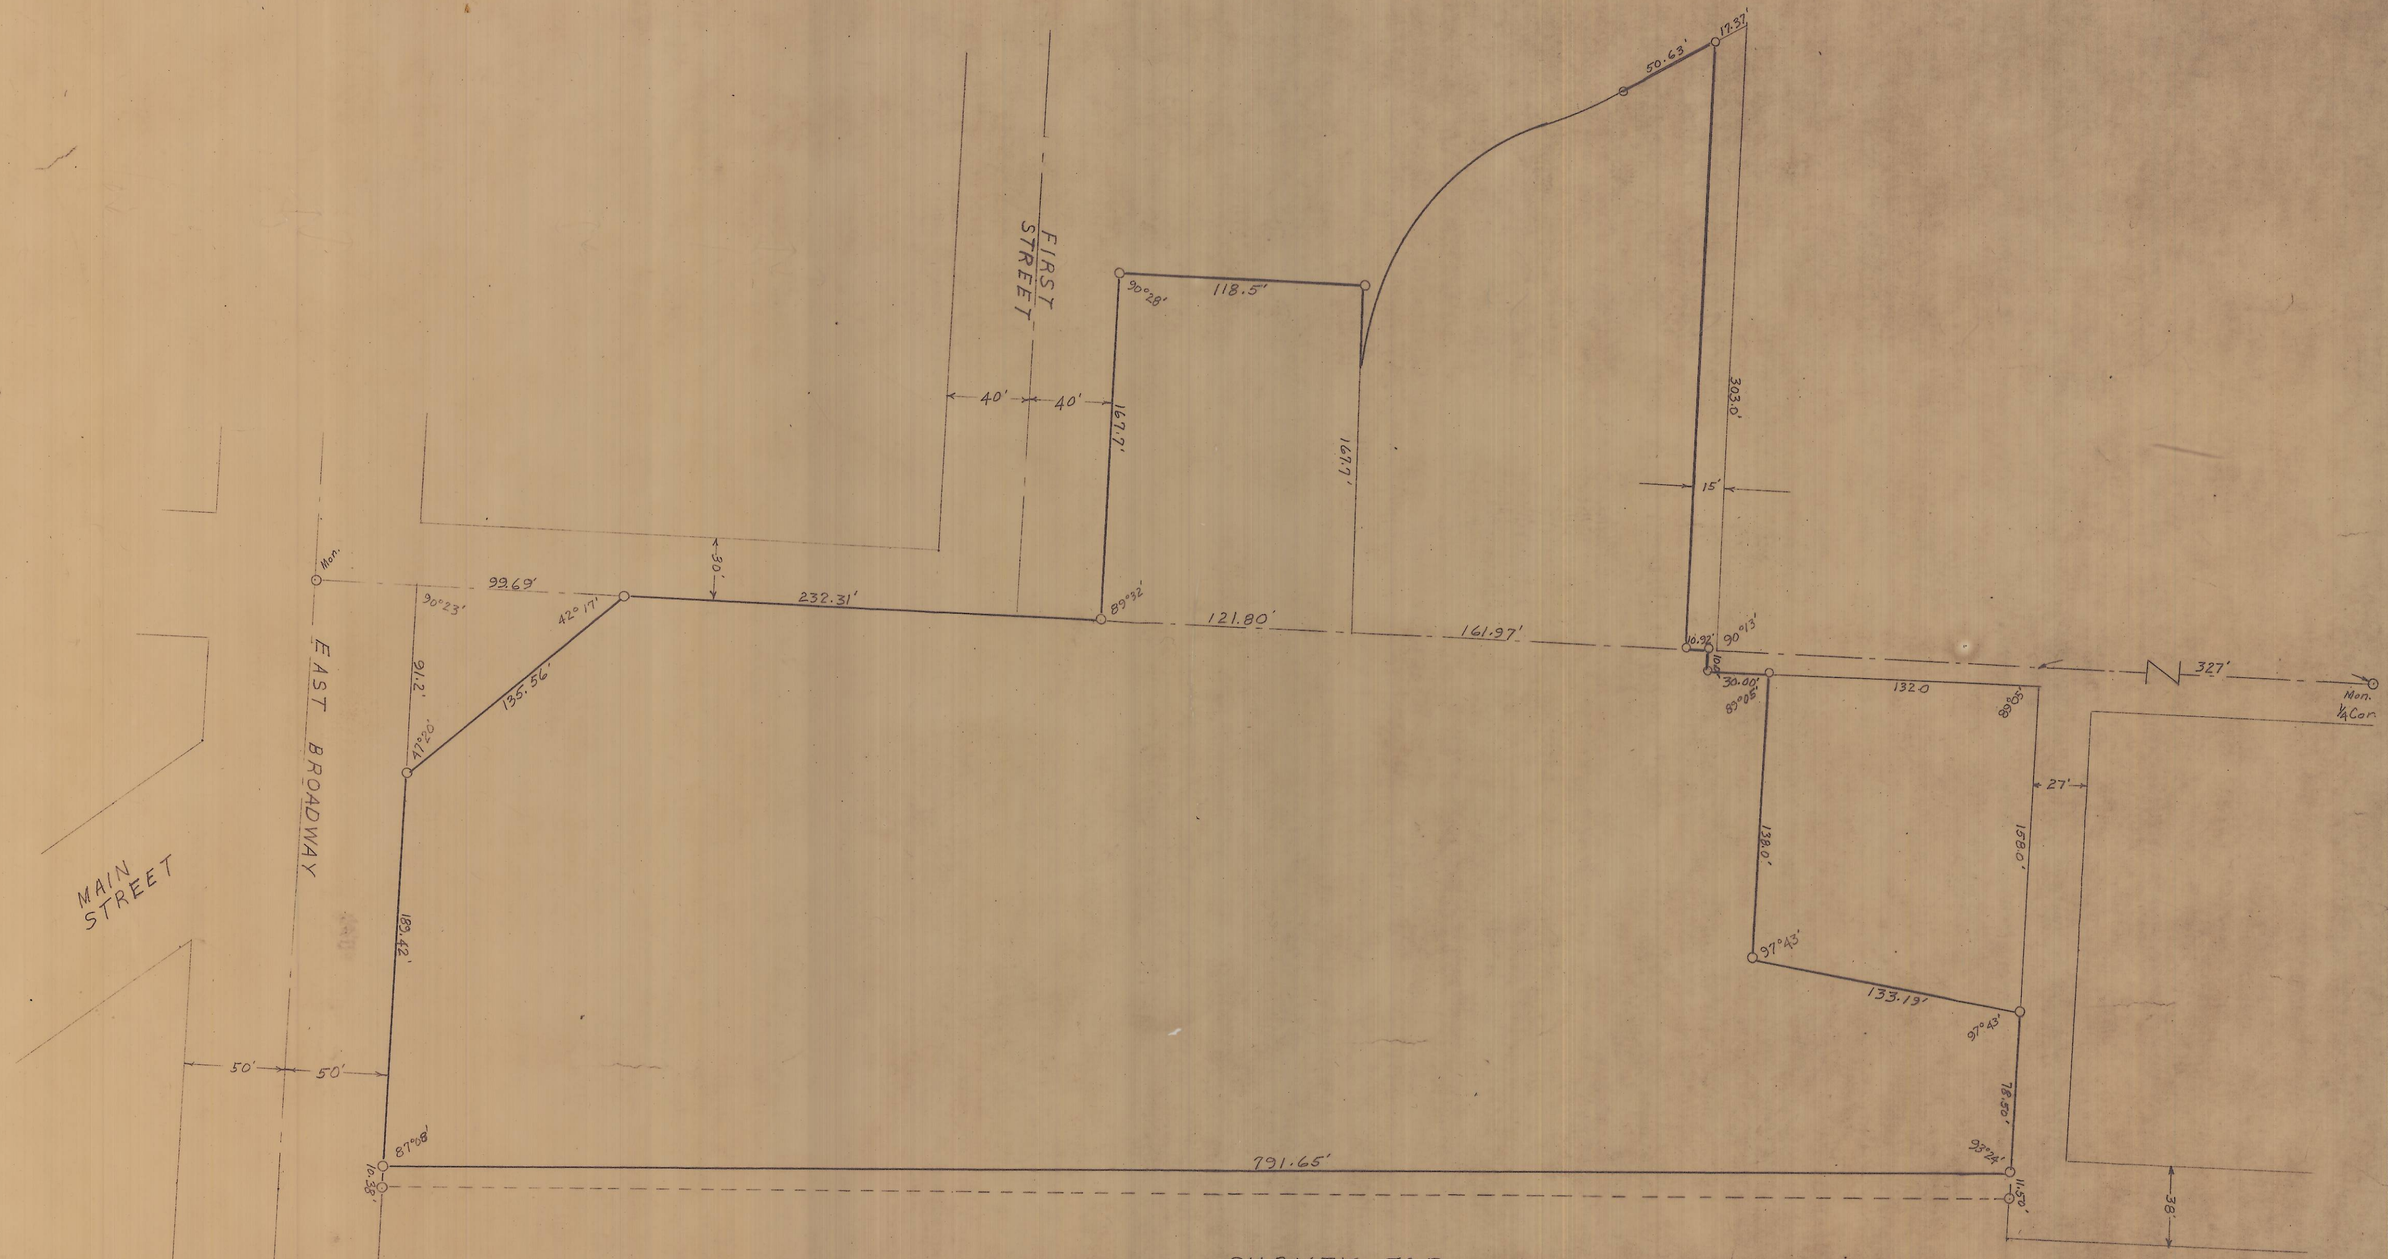

SURVEY FOR
BLUE MOUNTAIN PRUNE GROWERS COOPERATIVE
MILTON-FREEWATER, OREGON

Scale 1" = 50' MAR. 24, 1971

Guy W. Streamer Jr.
PROFESSIONAL ENGINEER

GUY W. STREAMER, JR. STATE OF WASHINGTON REGISTERED Professional Engineer & Land Surveyor

REGISTERED PROFESSIONAL ENGINEER 4813 OREGON JAN. 12, 1962 GUY W. STREAMER, JR.

Guy W. Streamer Jr.

H-140-B

Survey 553
H-140-B

5N-35
02DA