


23 24

10000N

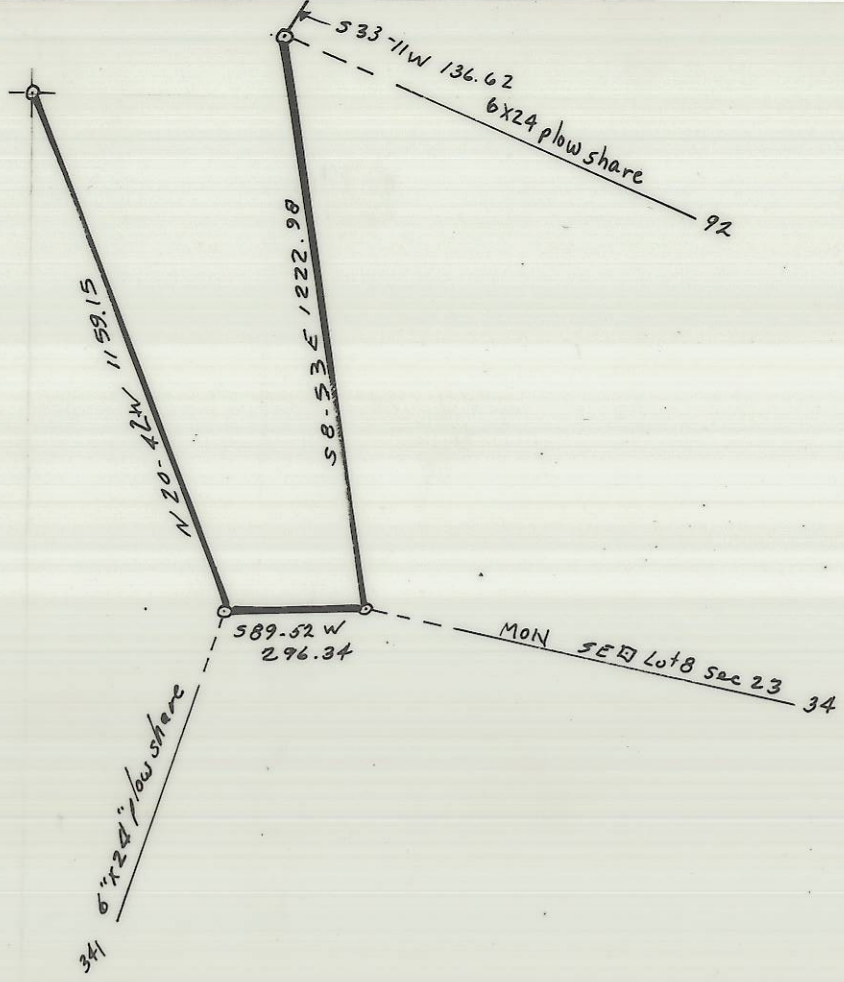

50000N

6000N

4A

OREGON
 MCKAY CREEK NWR
 SCALE 1"=400'
 Surveyed 1938

H-252
 H-252

H-252-B