
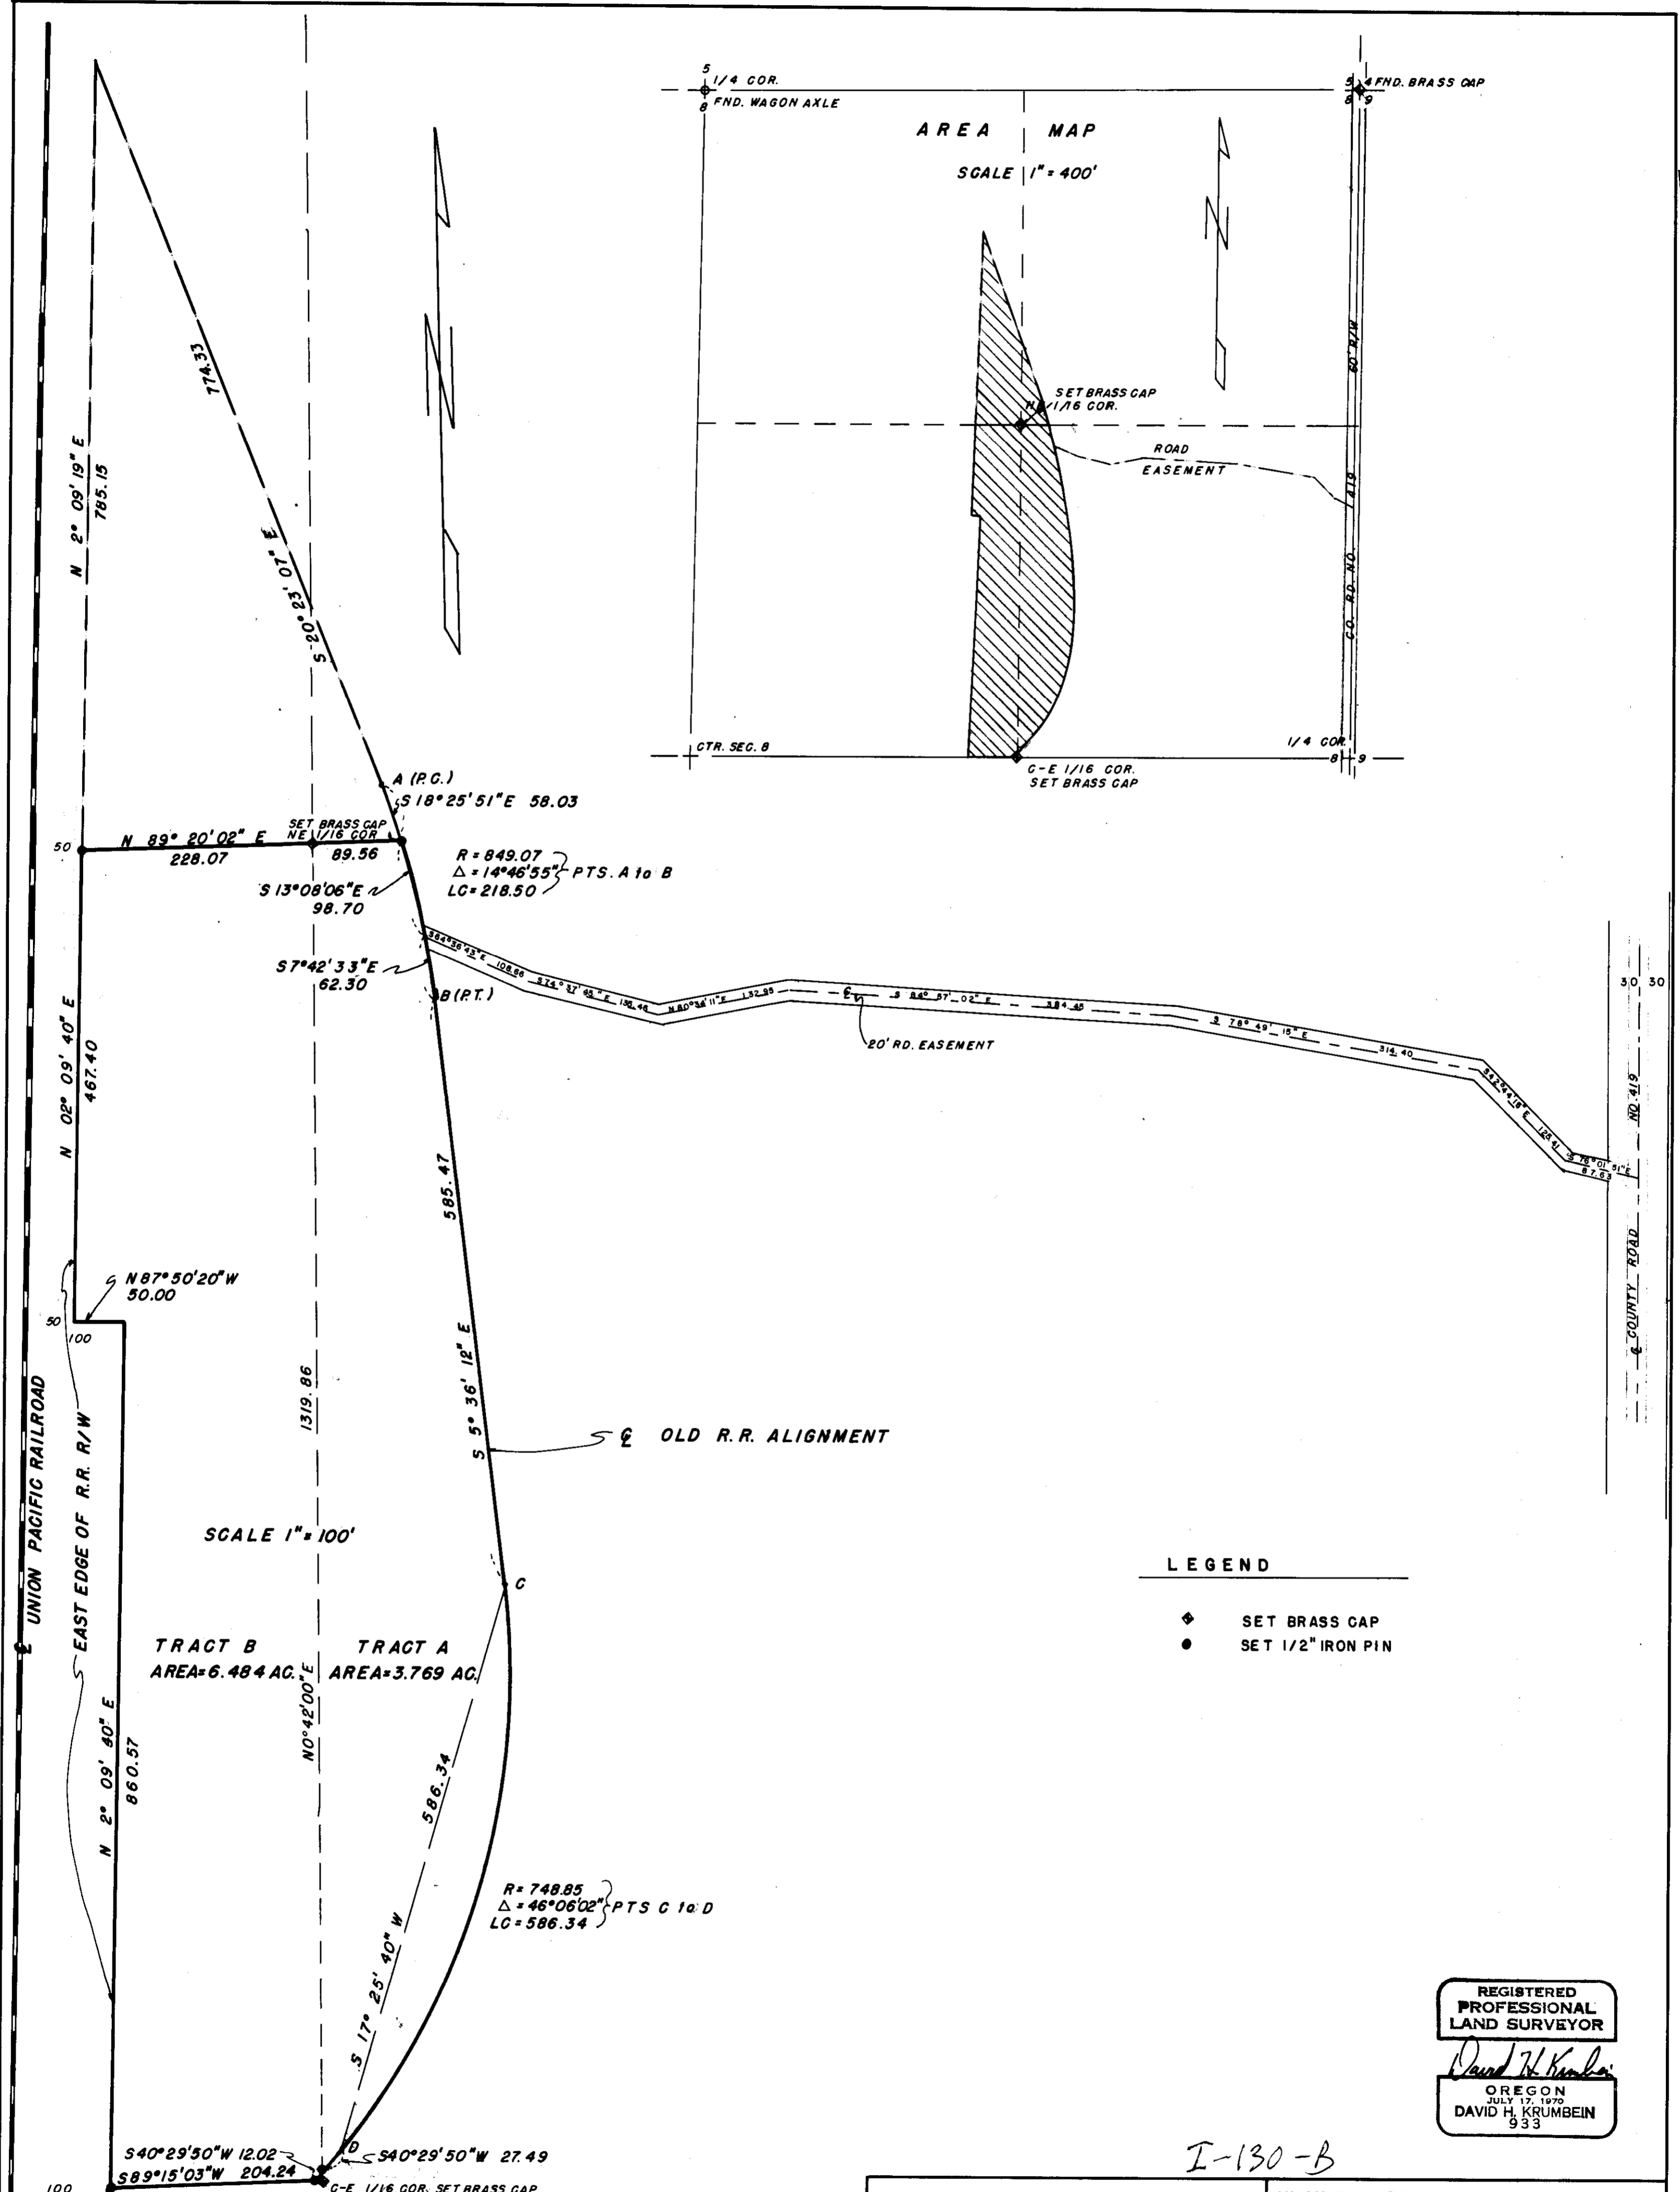


I-130-B
74-338

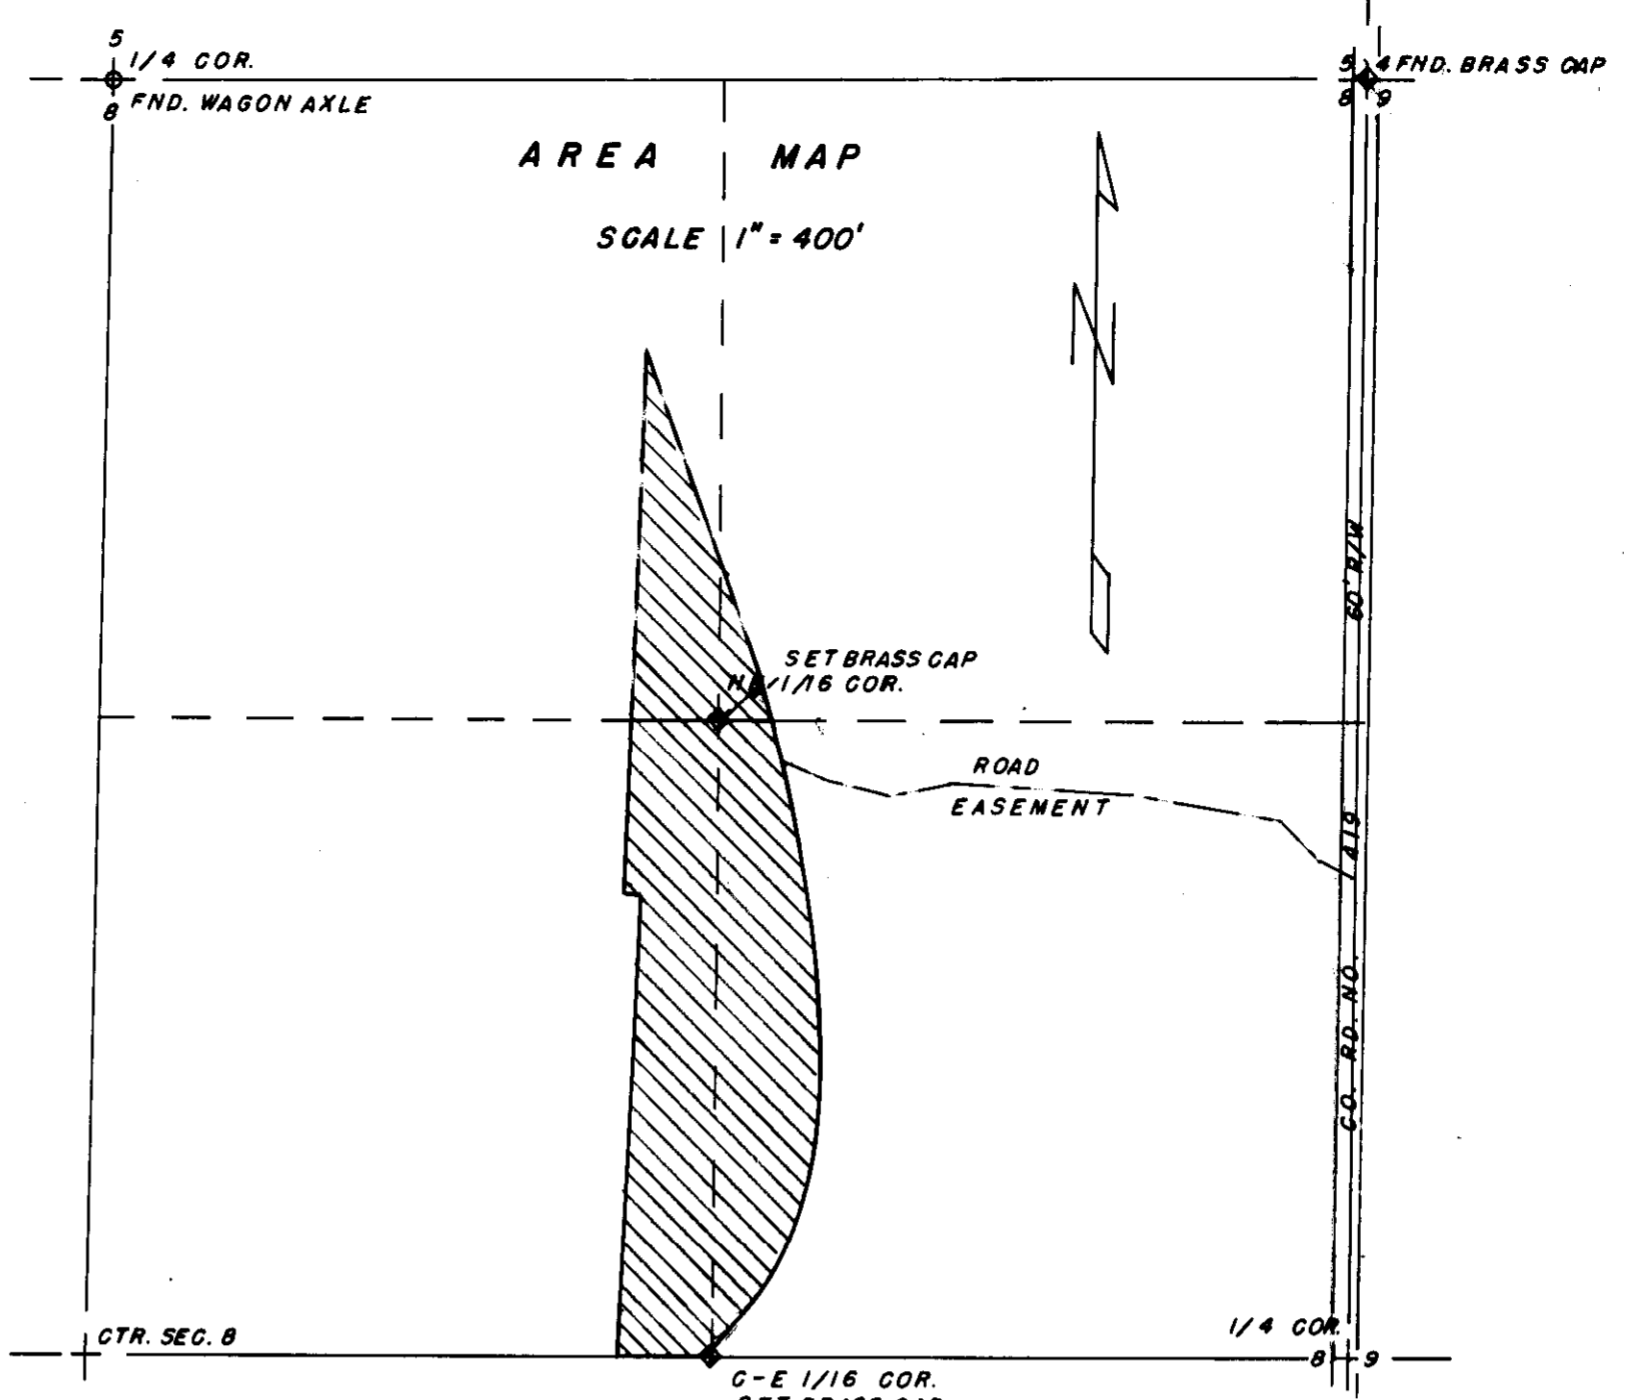

- LEGEND**
- ◆ SET BRASS CAP
 - SET 1/2" IRON PIN

REGISTERED
PROFESSIONAL
LAND SURVEYOR

David H. Krumbein

OREGON
JULY 17, 1970
DAVID H. KRUMBEIN
933

I-130-B

SURVEY FOR CITY OF ECHO, OREGON SEC. 8, T.3N., R.29E.W.M.		WAYNE HARRIS CO. INC. ENGINEERS SURVEYORS PENDLETON OREGON			
SCALE	ASSNOWN	DRN. BY	<i>D.H.K.</i>	DRNG. NO.	
DATE	11-5-74	CKD. BY	<i>D.H.K.</i>	74-338	